

604
5-19-64

WATER WELL DRILLERS LOG

Date: 5/19, 1964, Driller: Frank Wiley, Sr. County: Scott
(Name)

(1) Owner of Land: Marshall A. Niley
(Name)
Homewood, Miss.
(Address)

(2) Location: 1/4, 1/4, Sec. 35 T. 5N R. 2E
3 miles Southeast of Homewood
(distance) (direction) (Nearest Town)

(3) Topography: Flat
(Hilly) (Flat) (Level)

(4) Purpose of Well: Home
(Domestic Irrigation
Municipal, Industrial, Other)

Description & Color of Materials Sand, Clay, Red Clay, Shell, etc.	Thick- ness Feet	Depth Feet
<u>Red Clay</u>	<u>12</u>	<u>12</u>
<u>Clay & Silty Sand</u>	<u>22</u>	<u>34</u>
<u>Sand</u>	<u>32</u>	<u>66</u>
<u>Fine Sand</u>	<u>72</u>	<u>138</u>
	<u>131</u>	<u>131</u>

Information upon completion of well:

(1) Diameter 2 inches.

(2) Total Depth 131 feet.

(3) Water Level 87 feet below top of ground.

(4) Cased to 126, Size 2"


(5) Screen: Size 2", Length 5ft.

(6) Were any formations sealed against pollution?
 yes, no.

If YES depth of formation _____

Why _____

Drillers Remarks: _____

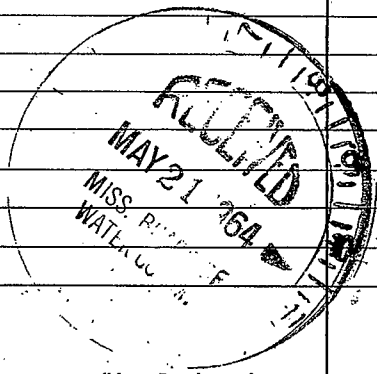

(Use Back Side)

Well No.

