

SCOTT MISSISSIPPI BOARD OF WATER COMMISSIONERS

605
10-14-65

WATER WELL DRILLERS LOG

Date: 10-14, 1965, Driller: Just Drilling County Scott
(Name)

(1) Owner of Land:	Description & Color of Materials Sand, Clay, Red Clay, Shell, etc.	Thick- ness Feet	Depth Feet
<u>Giddis + Giddis</u> (Name) <u>Quincy, Miss</u> (Address)	<u>Red Clay</u>	<u>0</u>	<u>12</u>
(2) Location: <u>1/4</u> , <u>1/4</u> , Sec. <u>17</u> T. <u>R</u> <u>12</u> miles <u>SW</u> of <u>Just</u> (distance) (direction) (Nearest Town)	<u>Sand + Clay</u> <u>Sand</u> <u>Clay</u>		<u>32</u> <u>64</u> <u>70</u>
(3) Topography: _____ (Hilly) (Flat) (Level)			
(4) Purpose of Well: <u>Chicken Farm</u> (Domestic Irrigation Municipal, Industrial, Other)			

Information upon completion of well:

(1) Diameter 2 inches.

(2) Total Depth 62 feet.

(3) Water Level 45 feet below top of ground.

(4) Cased to 57, Size 2"


(5) Screen: Size 2", Length 57'

(6) Were any formations sealed against pollution?
_____ yes, ✓ no.

If YES depth of formation _____

Why _____

Drillers Remarks: _____

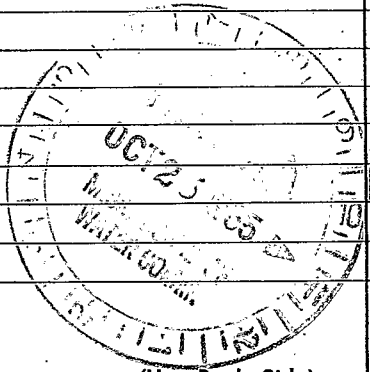

(Use Back Side)

Well No.

