

WATER WELL DRILLERS LOG

Date: 4-18, 1962, Driller: LEACH County SCOTT

(Name)

(1) Owner of Land: RAY MANGUM  
(Name)

Description & Color of Materials Sand, Clay, Red Clay, Shell, etc.	Thick- ness Feet	Depth Feet
---	------------------------	---------------

MORTON MISS  
(Address)

<u>GUMMEY CLAY</u>	<u>40</u>	
<u>BLUE CLAY</u>	<u>110</u>	<u>150</u>
<u>YELLOW CLAY</u>	<u>80</u>	<u>230</u>
<u>SHELL SAND</u>	<u>146</u>	<u>376</u>
<u>CLAY &amp; SAND</u>	<u>70</u>	<u>446</u>
<u>SAND</u>	<u>70</u>	<u>516</u>

(2) Location: 1/4, 1/4, Sec. 11 T. R.

8 miles SW of FOREST  
(distance) (direction) (Nearest Town)

(3) Topography: FLAT  
(Hilly) (Flat) (Level)

(4) Purpose of Well: DOMESTIC  
(Domestic Irrigation  
Municipal, Industrial, Other)

Information upon completion of well:

(1) Diameter 2 inches.

(2) Total Depth 516 feet.

(3) Water Level 220 feet below top of ground.

(4) Cased to 516, Size 2"

(5) Screen: Size 2", Length 6'


(6) Were any formations sealed against pollution?

no yes, no no.

If YES depth of formation \_\_\_\_\_

Why \_\_\_\_\_

Drillers Remarks: \_\_\_\_\_

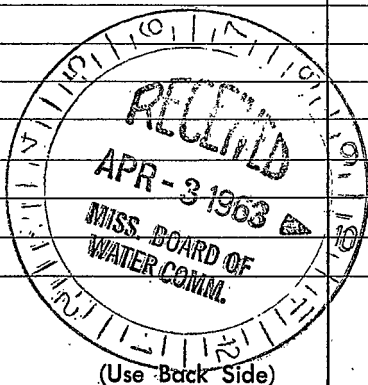

Well No. \_\_\_\_\_

1912

1912

