

SCOTT MISSISSIPPI BOARD OF WATER COMMISSIONERS

609
10-16-60

WATER WELL DRILLERS LOG 0-300

Date: 10/16, 19 60, Driller: Johnnie Beasley County ~~Smith~~ Scott
(Name)

(1) Owner of Land: Troy Boyles
(Name)

Pulaski, Miss.
(Address)

(2) Location: 1/4, 1/4, Sec. 30 T 12 E
_____ miles South, of Forest.
(distance) (direction) (Nearest Town)

(3) Topography: (Hilly) (Flat) (Level)

(4) Purpose of Well: Poultry & Home
(Domestic Irrigation, Municipal, Industrial, Other)


Information upon completion of well:

- (1) Diameter 2" inches.
- (2) Total Depth 612 feet.
- (3) Water Level 155 feet below top of ground.
- (4) Cased to 597', Size 2"
- (5) Screen: Size 2", Length 15'
- (6) Were any formations sealed against pollution?
yes, no.

If YES depth of formation _____
Why _____

Drillers Remarks: Good Well

Description & Color of Materials Sand, Clay, Red Clay, Shell, etc.	Thick- ness Feet	Depth Feet
Clay.	0	50
Blue Clay & Stks. Sand.	50	80
Blue Clay.	80	225
Blue Clay & Stks. Shale	225	348
Lime & Shale.	348	410
Shale, Shell & Sand.	410	435
Soft Clay & Sandy Merral.	435	450
Mucky Sand.	450	458
Fine Mucky Sand	458	470
Shale, Lignite & Muck	470	490
Fine Sand.	490	546
Shale & Stks. Sand.	546	553
Fine Sand.	553	574
Shale & Sand.	574	581
Sand. (Screen Setting)	581	612

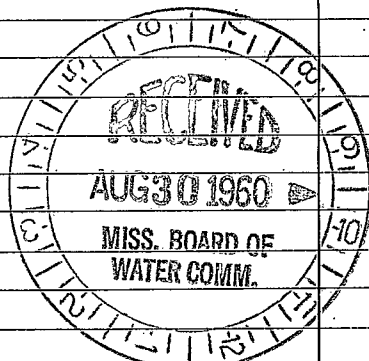

(Use Back Side)

Well No.

5777

1953
1954
1955

