

Scott
 11
 12-69

MISSISSIPPI
 BOARD OF WATER COMMISSIONERS
 416 North State Street
 Jackson, Mississippi 39201

CODED my copy

WATER WELL DRILLERS LOG

Dec 1969 date well completed
 W. Kerson Drilling firm name
 Scott county well located

LANDOWNER: E.A. SCOTT

description of formations encountered	from	to
Yellow Clay	0	50
Blue "	50	162
Rock & clay	162	165
Clay like	165	250
Shale	250	340
black + sand	340	350
brown clay	350	410
sand + shale	410	500

Forest Miss
 (mailing address)

WELL LOCATION:
 sec 2 T 5 N R 7 E
 10 miles S.W. of Forest
 (distance) (direction) (nearest town)

WELL PURPOSE: home
 (home, irrigation, municipal, industrial)

WELL COMPLETION DATA:

- (1) diameter (inches) 2
- (2) total depth (feet) 477
- (3) static water level (feet) 126 below top of ground.
- (4) casing GALV, 463 (material), (depth)
- (size) if telescope see back.
- (5) screen 4' 477 (length), (depth to top)
- 2 STAINLESS STEEL (size), (material)
- (6) pump 3 12 (HP), (yield gpm)
- 51cc (type power)
- (7) electric log NO (yes or no)
- (organization running log)
- (8) how well bottom plugged 2" BULL

CODED


MAR 10 1970

MISS. BD. OF WATER COMM.

DRILLERS REMARKS:

If well telescopes please sketch and show depths.

GROUND LEVEL

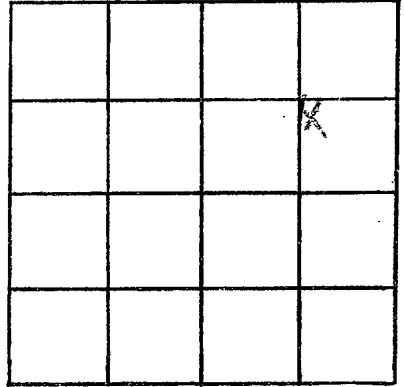

SECTION 2

Please indicate well location X.

ADDITIONAL INFORMATION

If more than one screen, show locations of each on sketch.