

SCOTT
 013
 9-12-73

MISSISSIPPI
 BOARD OF WATER COMMISSIONERS
 416 North State Street
 Jackson, Mississippi 39201

CODEE

WATER WELL DRILLERS LOG

9-11 1973 date well completed
 Wilkerson Drilling firm name
 Scott county well located

LANDOWNER:	description of formations encountered	from	to
Mr. David Hawkins	Sand + Gravel	0	20
Morton Miss (mailing address)	CLAY Blue	20	300
	hard clay	300	425
	Band of clay	425	440
	SAND	440	550
WELL LOCATION: sec. 27 T 5 N R 7 E S W			
5 miles S.E. of Pelasko (distance) (direction) (nearest town)			
WELL PURPOSE: home (home, irrigation, municipal, industrial)			
WELL COMPLETION DATA:			
(1) diameter (inches) 2			
(2) total depth (feet) 250			
(3) static water level (feet) 122 below top of ground.			
(4) casing GALV, 545, (material) (depth)			
if telescope see back. (size)			
(5) screen 5, 550 (length) (depth to top)			
2, STAINLESS Steel (size) (material)			
(6) pump 3, 11 (HP) (yield gpm)			
51ec (type power)			
(7) electric log NO (yes or no)			
(organization running log)			
(8) how well bottom plugged 2 BULL			
DRILLERS REMARKS:			


CODED

SEP 24 1973

MISS. BD. OF
 WATER COMMISSIONERS

If well telescopes please sketch and show depths.

GROUND LEVEL

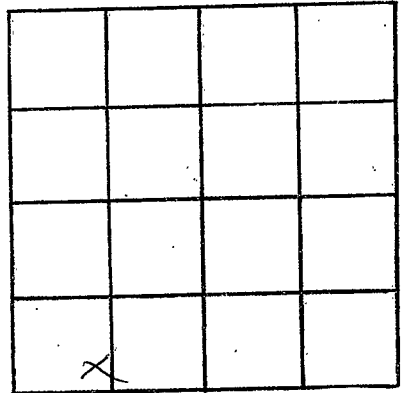

SECTION _____

Please indicate well location X.

ADDITIONAL INFORMATION

If more than one screen, show locations of each on sketch.