

MISSISSIPPI DEPARTMENT OF ENVIRONMENTAL QUALITY
Bureau of Land and Water Resources

P. O. Box 10631
Jackson, MS 39289-0631
WATER WELL DRILLERS LOG

| | |
|--|-------|
| COUNTY WELL LOCATED Scott | |
| WELL NUMBER Φ 15 | CODED |
| DATE WELL COMPLETED 12/10/90 | |

| |
|--|
| PERMIT NUMBER 0-402 |
| NAME OF DRILLING FIRM Tom Griffith |
| Water Well |

| | | |
|---|----------------------|----------------------|
| NAME & MAILING ADDRESS OF LANDOWNER Exeter Drilling Co. | | |
| Southern Division | | |
| P.O. Box 1478 | | |
| Houston, TX 77251-1478 | | |
| WELL LOCATION: SEC | TOWNSHIP | RANGE |
| 17 | 5^N | 7^W |
| DISTANCE | DIRECTION | NEAREST TOWN |
| 1 Miles | W | Pulaski |
| OTHER LANDMARK 2100' N + 150' E of SW/CR | | |
| WELL PURPOSE: Home, Irrigation, Municipal, Industrial, Fish Pond, etc. rig supply | | |

| | | |
|---|----------------------------|---------------------------------|
| PUMP DATA | | |
| PUMP TYPE (Circle One): Submersible , Turbine, Jet, Flowing Well, Other (Describe) _____ | | |
| POWER TYPE (Circle One): Electric, Tractor, Diesel, Gasoline, Butane, Other (Describe) 5 H/P _____ | | |
| Pump Capacity (GPM) 75 | No. of Stages 20 | Setting Depth 250 FT. |
| PUMP TEST | | |
| Well yielded 75 GPM with a drawdown of _____ ft. after _____ hours of pumping | | |

| | | |
|---|------------------------------------|------------------------------------|
| Well Depth 470' | Casing Diameter (In.) 4" | Casing Length (Ft.) 430' |
| Type of Casing PVC | Hole Depth 470' | Depth to Static Water Level |
| TYPE OF COMPLETION: (Circle One or More): Gravel Packed, Underreamed, Telescoped, Natural Development , Open Hole, Other (Describe) _____ | | |
| Top of Lap Pipe or Reduction in Casing FEET IF TELESCOPED OR MORE THAN ONE SCREEN: USE BACK PAGE | | |

| | |
|---|--|
| LOG DATA | |
| TYPE OF LOG RUN (Circle One): Electric, Gamma Ray, Density, Sonic, No Log Run , Other (Describe) _____ | |
| Name of Organization Running Log | |

| | | |
|--------------------------------|---------------------------------------|-----------------------------------|
| SCREEN DATA | | |
| Diameter - Inches 4" | Length - Feet 140' | Slot Size - Inches .020 |
| Screen Type PVC Slot | Depth to Bottom - Feet 470' | |


| | | | |
|--|---------------|----------------|--------------|
| GEOLOGIC DATA (Office Use Only) | | | |
| Surface Elev. | Geologic Unit | Unit Thickness | Depth to Top |
| Subs. SWL | Date | Analysis | Aquifer Test |
| Driller's Remarks: | | | |

| DESCRIPTION OF FORMATIONS ENCOUNTERED | FROM | TO |
|---------------------------------------|------------|------------|
| Clay | 1 | 18 |
| Blue Clay | 18 | 200 |
| Fine Sand | 200 | 205 |
| Limestone | 205 | 230 |
| Rock | 230 | 235 |
| Clay | 235 | 420 |
| Sand | 420 | 470 |
| | | |
| | | |
| | | |

| FORMATIONS (Continued) | FROM | TO |
|--|------|----|
| RECEIVED | | |
| JAN 14 1991 | | |
| Dept. of Environmental Quality Bureau of Land & Water Resources | | |
| IF MORE SPACE IS NEEDED, USE BACK | | |

If well telescopes please
sketch and show depths.

GROUND LEVEL

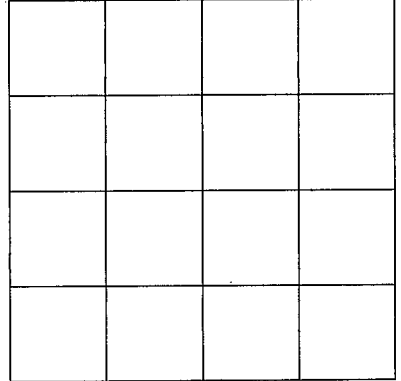

SECTION _____

Please indicate well location X.

ADDITIONAL INFORMATION

If more than one screen,
show location of each on sketch.