

MISSISSIPPI DEPARTMENT OF ENVIRONMENTAL QUALITY

Office of Land and Water Resources

P. O. Box 10631
Jackson, MS 39289-0631
WATER WELL DRILLERS LOG

COUNTY WELL LOCATED SCOTT	
WELL NUMBER 2	CODED
Q-20	
DATE WELL COMPLETED 8-4-00	

PERMIT NUMBER
NAME OF DRILLING FIRM PARTNER WELL SERVICE

NAME & MAILING ADDRESS OF LANDOWNER
DOUGLAS WILKERSON
RT PLASKI MS

PUMP DATA

PUMP TYPE (Circle One):
 Submersible Turbine Jet Flowing Well,
Other (Describe) _____

POWER TYPE (Circle One):
 Electric Tractor, Diesel, Gasoline, Butane,
Other (Describe) _____ H/P **2**

WELL LOCATION: SEC TOWNSHIP RANGE

2 **32** **5** **N 7 W**

Pump Capacity (GPM) No. of Stages Setting Depth

20 **14** **230** FT.

DISTANCE DIRECTION NEAREST TOWN

12 Miles **South** of **MORTON**

PUMP TEST

Well yielded **30** GPM with
a drawdown of **40** ft.
after **12** hours of pumping

OTHER LANDMARK
TRENTON COM.
chicken Houses

WELL PURPOSE: Home, Irrigation, Municipal, Industrial, Fish Pond, etc.

WELL DATA

Well Depth 640	Casing Diameter (In.) 4" 2"	Casing Length (Ft.) 460 4" 130 2"
Type of Casing PVC	Hole Depth 605	Depth to Static Water Level 140

LOG DATA

TYPE OF LOG RUN (Circle One): No Log Run,
Electric, Gamma Ray, Density, Sonjc, Neutron,
Other (Describe) _____

Name of Organization Running Log
STATE

TYPE OF COMPLETION: (Circle One or More):
 Gravel Packed, Underreamed, Telescoped,
 Natural Development, Open Hole, Other
(Describe) _____

GEOLOGIC DATA (Office Use Only)

Surface Elev.	Geologic Unit	Unit Thickness	Depth to Top
Subs. SWL	Date	Analysis	Aquifer Test

WELL GROUTED TO A DEPTH OF **12** FEET
Type Grout (circle one): Cement, Bentonite, or Mix

SCREEN DATA

Diameter - Inches 2"	Length - Feet 15	Slot Size - Inches .005
Screen Type steel	Depth to Bottom - Feet 605	

Driller's Remarks
MAid well @
585 TO 605

Top of Lap Pipe or Reduction in Casing


FEET IF TELESKOPED OR MORE THAN ONE SCREEN: USE BACK PAGE

DESCRIPTION OF FORMATIONS ENCOUNTERED	FROM	TO	FORMATIONS (Continued)	FROM	TO
CLAY	0	65	PREVIOUS AUG 21 2000 Dept. of Environmental Quality Office of Land & Water Resources		
SAND	65	80			
CLAY	80	470			
SAND & CLAY	470	505			
CLAY	505	550			
SAND	550	605			
CLAY	605	640			

IF MORE SPACE IS NEEDED, USE BACK

If well telescopes please sketch and show depths.

GROUND LEVEL

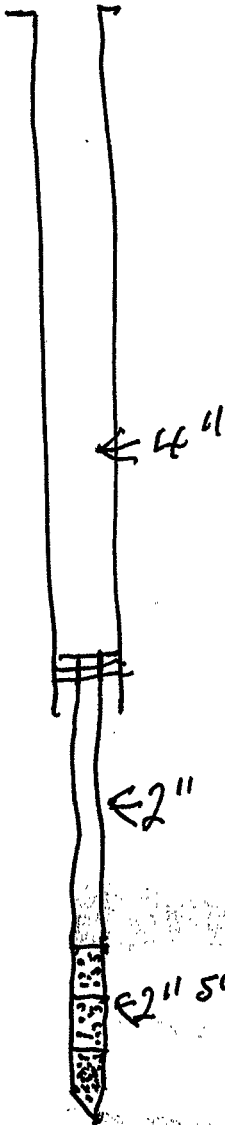

If more than one screen, show location of each on sketch.

		32	

TSW

R 7 E

SECTION 32

Please indicate well location X.

ADDITIONAL INFORMATION

USED 005 SLOT SCREENS
AND 2 H.P. 20 G.P.H.
PER MIN. TO KEEP FROM
PUSHING WELL SO HARD
NO SAND