

SCOTT

0 2000

5-29-78

MISSISSIPPI  
 BOARD OF WATER COMMISSIONERS  
 416 North State Street  
 Jackson, Mississippi 39201

WATER WELL DRILLERS LOG

5-29-78

McDonnell & Hill


Scott

date well completed

firm name

county well located

LANDOWNER:	description of formations encountered	from	to
Dennis Ronell	clay	0	20
Rt #1 Pulaski, Miss (mailing address)	clay & sand	20	45
WELL LOCATION:	shale	45	60
sec. 32 T 5 N R 7 E 3 miles S of Pulaski (distance) (direction) (nearest town)	blue shale	60	200
WELL PURPOSE: home (home, irrigation, municipal, industrial)	green shale	200	335
WELL COMPLETION DATA:	lime shale & rock	335	390
(1) diameter (inches) 4"	lime sand & shells	390	400
(2) total depth (feet) 610'	shale & fine sand	400	580
(3) static water level (feet) 130' below top of ground.	sand	580	610
(4) casing PVC 467' (material) (depth) 4" if telescope see back. (size)			
(5) screen 10' 590 to 600' (length) (depth to top) 3" PVC (size) (material)			
(6) pump 3/4 6000 (HP) (yield gpm) E (type power)			
(7) electric log (yes or no)			
(organization running log)			
(8) how well bottom plugged in line			
DRILLERS REMARKS:			

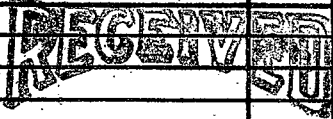

JUN - 1 1978

MISS. BD. OF WATER COMMISSIONERS

If well telescopes please sketch and show depths.

GROUND LEVEL


SECTION \_\_\_\_\_

Please indicate well location X.

ADDITIONAL INFORMATION

If more than one screen, show locations of each on sketch.