

MISSISSIPPI DEPARTMENT OF ENVIRONMENTAL QUALITY

Office of Land and Water Resources

P. O. Box 10631  
Jackson, MS 39289-0631  
WATER WELL DRILLERS LOG

COUNTY WELL LOCATED  
SCOTT

WELL NUMBER 2002 CODED

DATE WELL COMPLETED  
9-11-98

PERMIT NUMBER

NAME OF DRILLING FIRM  
PARKER WELL SERVICE

NAME & MAILING ADDRESS OF LANDOWNER  
DOUGLAS WILKERSON  
PULASKI MS.

PUMP DATA

PUMP TYPE (Circle One):  
submersible, Turbine, Jet, Flowing Well,  
Other (Describe)

POWER TYPE (Circle One):  
Electric, Tractor, Diesel, Gasoline, Butane,  
Other (Describe) H/P 5

WELL LOCATION: SEC 5 TOWNSHIP N 7 W RANGE

Pump Capacity (GPM) 60 No. of Stages 18 Setting Depth 210 FT.

DISTANCE 8 Miles DIRECTION S NEAREST TOWN MORTON

PUMP TEST

Well yielded 60 GPM with  
a drawdown of 50 ft.  
after 24 hours of pumping

OTHER LANDMARK  
481 - PULASKI  
WELL PURPOSE: Home, Irrigation, Municipal, Industrial, Fish Pond, etc.  
chicken Houses

WELL DATA

Well Depth 620 Casing Diameter (In.) 4" 2" Casing Length (Ft.) 500-4"  
390-2"

Type of Casing PVC Hole Depth 4" Depth to Static Water Level 100

LOG DATA

TYPE OF LOG RUN (Circle One): No Log Run, Electric, Gamma Ray, Density, Sonic, Neutron, Other (Describe)

Name of Organization Running Log

TYPE OF COMPLETION: (Circle One or More):  
Gravel Packed, Underreamed, Telescoped,  
Natural Development, Open Hole, Other

GEOLOGIC DATA (Office Use Only)

Surface Elev.	Geologic Unit	Unit Thickness	Depth to Top
Subs. SWL	Date	Analysis	Aquifer Test

WELL GROUTED TO A DEPTH OF 4 FEET  
Type Grout (circle one): Cement, Bentonite, or Mix

SCREEN DATA

Diameter - Inches	Length - Feet	Slot Size - Inches
<u>2"</u>	<u>30'</u>	<u>006</u>

Screen Type PVC Depth to Bottom - Feet 620'

Driller's Remarks

Top of Lap Pipe or Reduction in-Casing

FEET IF TELESKOPED OR MORE THAN ONE SCREEN: USE BACK PAGE

DESCRIPTION OF FORMATIONS ENCOUNTERED	FROM	TO
<u>CLAY</u>	<u>0</u>	<u>70</u>
<u>SAND</u>	<u>70</u>	<u>90</u>
<u>BLUE CLAY</u>	<u>90</u>	<u>310</u>
<u>LAYERS ROCK</u>	<u>310</u>	<u>330</u>
<u>CLAY</u>	<u>330</u>	<u>500</u>
<u>SAND &amp; CLAY</u>	<u>500</u>	<u>580</u>
<u>SAND</u>	<u>580</u>	<u>620</u>

FORMATIONS (Continued)

FROM	TO

**RECEIVED**


FEB 01 1999

Dept of Environmental Quality  
Office of Land & Water Resources

IF MORE SPACE IS NEEDED...USE BACK

If well telescopes please sketch and show depths.

GROUND LEVEL

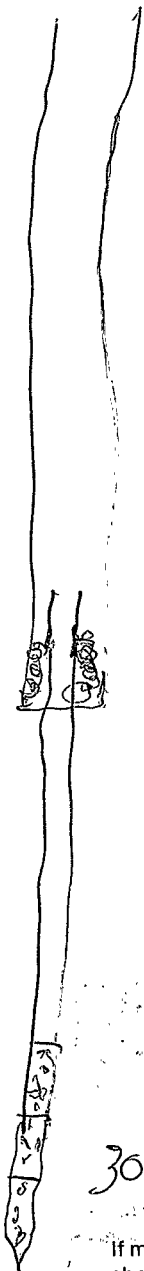

500 ft 4"

180 ft 2"

30 ft SCREEN

If more than one screen,  
show location of each on sketch.


SECTION \_\_\_\_\_

Please indicate well location X.

ADDITIONAL INFORMATION

GO TO HIGHWAY  
481 EAST OF I-20  
TAKE RIGHT GO  
8 TO 10 MILES  
TAKE RIGHT AT  
DOUGLAS WILKERSON  
CHICKEN HOUSES