

SCOTT

P. I.  
9-5-61

WATER WELL DRILLERS LOG

5

Date: 9/4 & 9/5 1961; Driller: Johnnie Beasley County Scott

(Name)

	Description & Color of Materials Sand, Clay, Red Clay, Shell, etc.	Thick- ness Feet	Depth Feet
(1) Owner of Land: <u>Horace Loftin</u> (Name)	<u>Yellow clay.</u>	<u>0-</u>	<u>25</u>
<u>Rt. 2, Forest, Miss.</u>	<u>Blue clay.</u>	<u>25-</u>	<u>170</u>
Go down Norris road to gravel pit and turn right for about 3 miles	<u>Lime &amp; clay.</u>	<u>170-</u>	<u>288</u>
(2) Location: <u>1/4, 1/4, Sec. 13, T. 1 R. 1</u> <u>13 side</u>	<u>Shale &amp; silt.</u>	<u>288-</u>	<u>308</u>
<u>8 miles South</u> of <u>Forest.</u>	<u>Silt &amp; stks. shale.</u>	<u>308-</u>	<u>316</u>
(distance) (direction) (Nearest Town)	<u>Fine sand.</u>	<u>316-</u>	<u>370</u>
(3) Topography: <u>x</u>	<u>Sand. ( Screen setting)</u>	<u>370-</u>	<u>389</u>
(Hilly), (Flat) (Level)			
(4) Purpose of Well: <u>Domestic.</u>			
(Domestic Irrigation Municipal, Industrial, Other)			


Information upon completion of well:

- (1) Diameter 2 inches.
- (2) Total Depth 389' feet.
- (3) Water Level 80' feet below top of ground.
- (4) Cased to 379', Size 2"
- (5) Screen: Size 2", Length 10'
- (6) Were any formations sealed against pollution?  
\_\_\_\_\_ yes, x no.

If YES depth of formation \_\_\_\_\_

Why \_\_\_\_\_

Drillers Remarks: Good well.

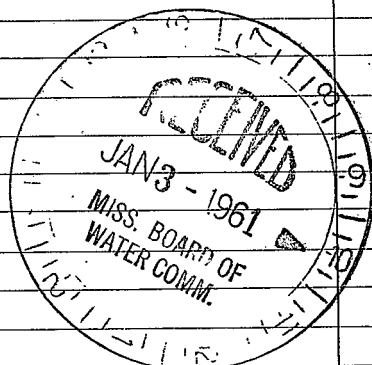

(Use Back Side)

Well No.

Retain this copy for your office files.

