

SCOTT MISSISSIPPI BOARD OF WATER COMMISSIONERS

PZ
12-15-61

WATER WELL DRILLERS LOG

Date: 12/14 & 12/19 61, Driller: Johnnie Beasley County Scott
(Name)

	Description & Color of Materials Sand, Clay, Red Clay, Shell, etc.	Thick- ness Feet	Depth Feet
(1) Owner of Land: <u>Clois Riser</u> (Name)			
This well located about <u>7 miles South</u> <u>Rt. 2, Forest, Miss.</u> (Address)	<u>Brown clay.</u>	<u>0-</u>	<u>25</u>
of Forest on Hwy. <u>35.</u>	<u>Blue clay.</u>	<u>25-</u>	<u>210</u>
(2) Location: <u>1/4, 1/4, Sec. 17 T. 36 R. 10 E.</u>	<u>Blue clay & stks. lime.</u>	<u>210-</u>	<u>308</u>
<u>7 miles South</u> of <u>Forest</u>	<u>Shale.</u>	<u>308-</u>	<u>316</u>
(distance) (direction) (Nearest Town)	<u>Fine sand.</u>	<u>316-</u>	<u>336</u>
(3) Topography: <u>X</u>	<u>Sand. (Screen setting)</u>	<u>336-</u>	<u>346</u>
(Hilly) (Flat) (Level)			
(4) Purpose of Well: <u>Domestic.</u>			
(Domestic Irrigation Municipal, Industrial, Other)			


Information upon completion of well:

- (1) Diameter 2 inches.
- (2) Total Depth 346' feet.
- (3) Water Level 107' feet below top of ground.
- (4) Cased to 336', Size 2"
- (5) Screen: Size 2", Length 10'
- (6) Were any formations sealed against pollution?
no yes, X no.

If YES depth of formation _____

Why _____

Drillers Remarks: Good well.

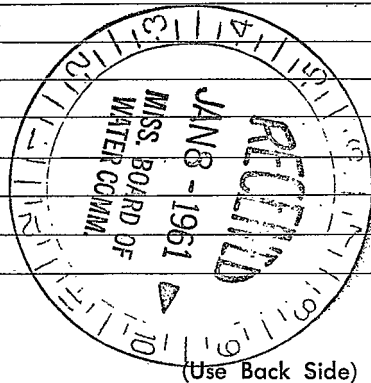

(Use Back Side)

Well No.

-
-
