

SCOTT MISSISSIPPI BOARD OF WATER COMMISSIONERS

473  
S 9-27-63

WATER WELL DRILLERS LOG

Date: 9/27, 1963, Driller: Frank Orly Sew County Scott  
(Name)

(1) Owner of Land: Carrie Gannoy  
(Name)  
Rt 2 Forest, Miss.  
(Address)  
(2) Location: 1/4, 1/4, Sec. 4 T R  
4 miles South of Forest  
(distance) (direction) (Nearest Town)  
(3) Topography: \_\_\_\_\_  
(Hilly) (Flat) (Level)  
(4) Purpose of Well: \_\_\_\_\_  
(Domestic Irrigation  
Municipal, Industrial, Other)


Description & Color of Materials Sand, Clay, Red Clay, Shell, etc.	Thick- ness Feet	Depth Feet
Clay	0	32
Blue clay		162
Clay + sths lime rock		187
Shale		207
Shale + sths rock		227
Clay + sths sandy shale		257
Shale		321
Shale + mky sand		331
Fine sand + sths clay		351
Fine sand		378
Clay + sths sand		418
Fine sand		441
Fine sand		451

Information upon completion of well:

(1) Diameter 2 inches.  
(2) Total Depth 451 feet.  
(3) Water Level 143 feet below top of ground.  
(4) Cased to 441, Size 2"  
(5) Screen: Size 2", Length 10ft.  
(6) Were any formations sealed against pollution?  
\_\_\_\_\_ yes, X no.

If YES depth of formation \_\_\_\_\_  
Why \_\_\_\_\_

Drillers Remarks: \_\_\_\_\_  
\_\_\_\_\_  
\_\_\_\_\_

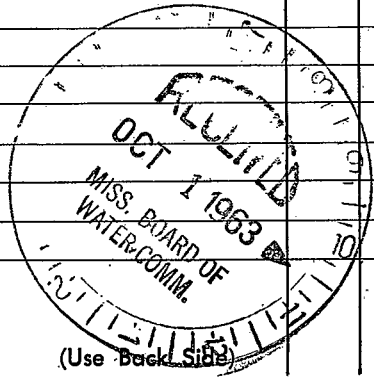

Well No. \_\_\_\_\_

[The page contains extremely faint and illegible text, likely bleed-through from the reverse side of the document. No specific words or phrases can be discerned.]