

WATER WELL DRILLERS LOG

6 P 9
6-10-61

②

Scott

Date: 6/10, 1961, Driller: James McGee County: Smith
(Name)

(1) Owner of Land: O. G. Henderson
(Name)
Rt. 2, Forest, Miss.
(Address)

(2) Location: 1/4, 1/4, Sec. 311 5N8E T. R.
10 miles South of Forest
(distance) (direction) (Nearest Town)

(3) Topography: X
(Hilly) (Flat) (Level)

(4) Purpose of Well: Domestic
(Domestic Irrigation
Municipal, Industrial, Other)

Description & Color of Materials Sand, Clay, Red Clay, Shell, etc.	Thick- ness Feet	Depth Feet
Clay.	0	42
Clay & sand.	42	52
Clay & stks. rock.	52	62
Clay.	62	102
Clay & stks. sand.	102	112
Clay & stks. sand.	112	137
Fine sand.	137	142
Clay.	142	156
Fine sand.	156	162
Clay & stks. sand.	162	180
Fine sand.	180	200
Clay.	200	202
Sand.	202	222

Information upon completion of well:

(1) Diameter 2 inches.

(2) Total Depth 220 feet.

(3) Water Level 115 feet below top of ground.

(4) Cased to 210', Size 2"


(5) Screen: Size 2", Length 10'

(6) Were any formations sealed against pollution?
yes, X no.

If YES depth of formation _____

Why _____

Drillers Remarks: Good well.

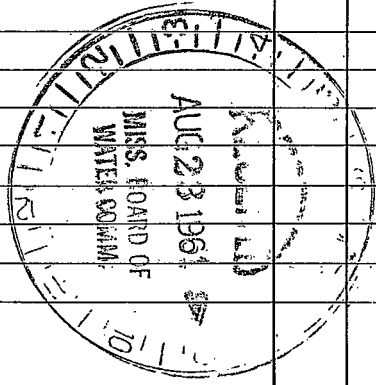

(Use Back Side)

Well No.

