

SCOTT MISSISSIPPI BOARD OF WATER COMMISSIONERS

P12  
9-25-63

WATER WELL DRILLERS LOG

Date: 9/25, 1963, Driller: Frostberg SW County Scott  
(Name)

(1) Owner of Land: Cliff Taddock  
(Name)  
Rt 2 Frostberg, Miss  
(Address)

(2) Location: 1/4, 1/4, Sec. 29 T. 15 R. 15  
10 miles South of Frostberg  
(distance) (direction) (Nearest Town)

(3) Topography: Level  
(Hilly) (Flat) (Level)

(4) Purpose of Well: House  
(Domestic Irrigation  
Municipal, Industrial, Other)

Description & Color of Materials Sand, Clay, Red Clay, Shell, etc.	Thick- ness Feet	Depth Feet
Red Hard Clay	0	12
Clay		22
Black clay		22
Shale + shells + sand		277
Shale		323
Clay + shell		333
Mud + shell		353
Soft shale		403
Mud clay + sand		413
Mud sand		420
Fine sand		425
Clay		433
Shale + shells + sand		443
Fine sand		472

Information upon completion of well:

(1) Diameter 2 inches.

(2) Total Depth 472 feet.

(3) Water Level 180 feet below top of ground.

(4) Cased to 462, Size 2"


(5) Screen: Size 2", Length 10ft

(6) Were any formations sealed against pollution?  
\_\_\_\_\_ yes, X no.

If YES depth of formation \_\_\_\_\_

Why \_\_\_\_\_

Drillers Remarks: \_\_\_\_\_

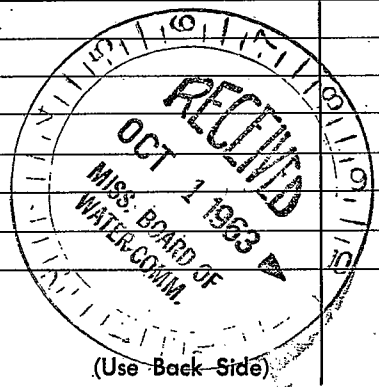

Well No.

