

SCOTT MISSISSIPPI BOARD OF WATER COMMISSIONERS

P13

10-19-63

WATER WELL DRILLERS LOG

Plot 4

Date: 10/19, 1963, Driller: Frank Dalg Miss County Scott
 (Name)

(1) Owner of Land: W. J. Johnson
 (Name)
Rt 2 Lake, Miss
 (Address)

(2) Location: 1/4, 1/4, Sec. 12 T. R
7 miles SE of Frank
 (distance) (direction) (Nearest Town)

(3) Topography: X
 (Hilly) (Flat) (Level)

(4) Purpose of Well: Home
 (Domestic Irrigation
 Municipal, Industrial, Other)

Description & Color of Materials Sand, Clay, Red Clay, Shell, etc.	Thick- ness Feet	Depth Feet
Red clay & Gravel	0	12
Brown clay		25
Blue clay		192
Clay & shell rock		255
Shale		267
Fine sand		303
Shale		307
Soft shale		343
Shale & shell sand		383
Fine sand & shell clay		393
Fine sand		411
Shale & shell fine sand		423
Shale		430
Fine sand & shell clay		453
Shale		500
Shale & rock		527
Clay & shell shale		537
Shale		575
Rock		578
Shale		585
Rock		586
Shale		588
Rock		588
Shale & rock		585
Shale		608
Fine sand & clay		623
Shale & shell sand		643
Fine sand & shell		663
Shale		678

Information upon completion of well:

(1) Diameter 2 inches.

(2) Total Depth 676 feet.

(3) Water Level 200 feet below top of ground.

(4) Cased to 661, Size 2"


(5) Screen: Size 2", Length 15

(6) Were any formations sealed against pollution?
X yes, X no.

If YES depth of formation _____

Why _____

Drillers Remarks: _____

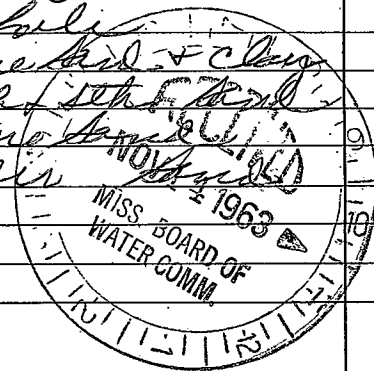

(Use Back Side)

Well No.

