

SCOTT
P 16
6-68

MISSISSIPPI
BOARD OF WATER COMMISSIONERS
416 North State Street
Jackson, Mississippi 39201

APR 12 1968
MISS. BOARD OF
WATER COMMISSIONERS

WATER WELL DRILLERS LOG

6-10 date well completed 1968 firm name COMENS Drilling Service county well located Scott

LANDOWNER: NOELAN Vetcher

description of formations encountered from to

Forest R# 2
Mud
(mailing address)

<u>Clay</u>	0	20
<u>Green Clay</u>	20	200
<u>Yazoo Clay</u>	250	280
<u>FAIR SAND</u>	280	310
	280	340
<u>Rocky Clay</u>	340	385
<u>SAND</u>	380	496

WELL LOCATION:
sec. 9 T. 5 N R. 8 E
S W
5 miles S of Forest
(distance) (direction) (nearest town)

WELL PURPOSE:
(home, irrigation, municipal, industrial)

BECOMING CORRO
With Depth

WELL COMPLETION DATA:


- (1) diameter (inches) 2"
- (2) total depth (feet) 456
- (3) static water level (feet) 100 below above top of ground.
- (4) casing 2" (material) (depth) (size) if telescope see back.
- (5) screen 0 (length) (depth to top) (size) (material)
- (6) pump (HP) (yield gpm) (type power)
- (7) electric log (yes or no) (organization running log)
- (8) how well bottom plugged

DRILLERS REMARKS:

APR 12 1968
MISS. BOARD OF
WATER COMMISSIONERS

If well telescopes please sketch and show depths.

GROUND LEVEL

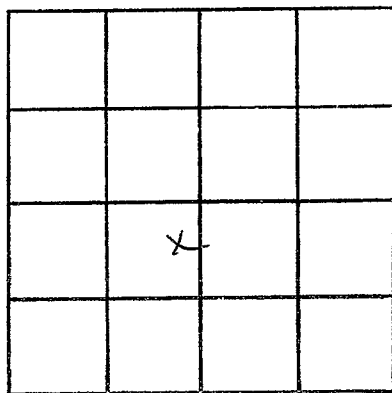

SECTION _____

Please indicate well location X.

ADDITIONAL INFORMATION

If more than one screen,
show locations of each on sketch.