

Scott

P 10

1-68

MISSISSIPPI
 BOARD OF WATER COMMISSIONERS
 416 North State Street
 Jackson, Mississippi 39201

CODED

WATER WELL DRILLERS LOG

Jan 28 1968 Wilkerred Drilling Scott
 date well completed firm name county well located

LANDOWNER: Heeban Gatewood

description of formations encountered

from to

Forest + MISS
(mailing address)

| | | |
|-------------|-----|-----|
| yellow clay | 0 | 30 |
| blue clay | 30 | 105 |
| Rocky sand | 105 | 108 |
| shale | 108 | 115 |
| shale | 115 | 180 |
| brown shale | 180 | 240 |
| sand | 240 | 280 |

WELL LOCATION:

sec. 12 T. 5 N. R. 8 E.
 S. W.
11 miles S of Forest
 (distance) (direction) (nearest town)

WELL PURPOSE: home
 (home, irrigation, municipal, industrial)

WELL COMPLETION DATA:

- (1) diameter (inches) 2
- (2) total depth (feet) 272
- (3) static water level (feet) 76 below top of ground.
- (4) casing Galv. 266
(material) (depth)

CODED

_____ if telescope see back.
(size)

- (5) screen 6 272
(length) (depth to top)
- 2 1/2" Stainless Steel
(size) (material)

- (6) pump 2 12
(HP) (yield gpm)

elec
(type power)

- (7) electric log NO
(yes or no)

_____ (organization running log)

- (8) how well bottom plugged 2 BeLU


MAR 4 1968

DRILLERS REMARKS:

MISS. BD. OF

If well telescopes please sketch and show depths.

GROUND LEVEL

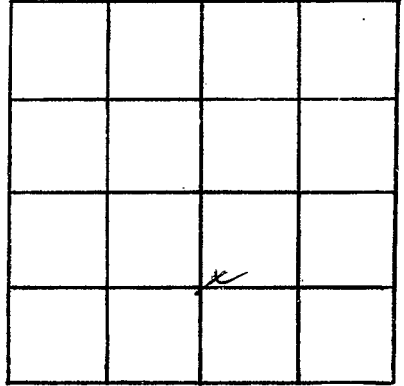

SECTION 12

Please indicate well location X.

ADDITIONAL INFORMATION

If more than one screen,
show locations of each on sketch.