

CODED

MISSISSIPPI
BOARD OF WATER COMMISSIONERS
416 North State Street
Jackson, Mississippi 39201

WATER WELL DRILLERS LOG

SCOTT
Levin

SCOTT
P 19
6-10-68

6-10-1968 *COMANS Drilling Service*
date well completed *COMANS Drilling Service* firm name

county well located

LANDOWNER: *NOYAN WELTCHER*

description of formations encountered

from to

Forest #2
M. Hill
(mailing address)

Clay 0 20
Green Clay 20 200
Yazoo Clay 200 280

WELL LOCATION:
sec. *9* T *5* N R *8* E
S W
5 miles *S* of *Forest*
(distance) (direction) (nearest town)

Five Sand 280 340
Rocky Clay 340 380

WELL PURPOSE: *Home*
(home, irrigation, municipal, industrial)

Sand 380 440

WELL COMPLETION DATA:

Bottoming Coarser
With Depth

(1) diameter (inches) *2"*

(2) total depth (feet) *456*

(3) static water level (feet) *110* below above top of ground.

(4) casing *Steel*, *1 1/2"*
(material) (depth)

_____ if telescope see back.
(size)

(5) screen *10*, *1 1/2"*
(length) (depth to top)

2", *5/8" / 1 1/2"*
(size) (material)

(6) pump _____
(HP) (yield gpm)

_____ (type power)

(7) electric log *NO*
(yes or no)

_____ (organization running log)

(8) how well bottom plugged _____



DRILLERS REMARKS:

FEB 12 1969

MISS. Bd. OF
WATER COMM

If well telescopes please sketch and show depths.

GROUND LEVEL

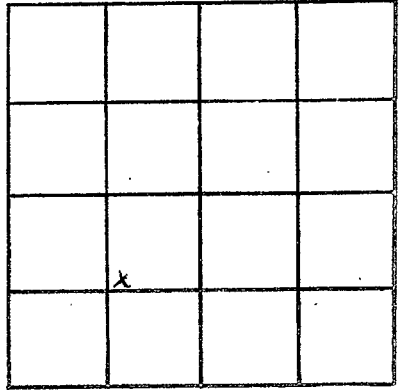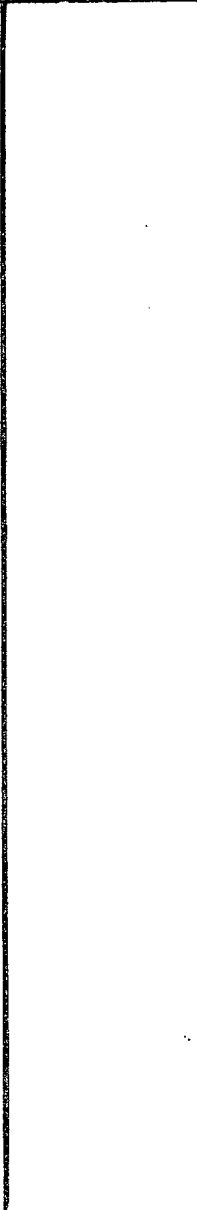

E

SECTION 7

Please indicate well location X.

ADDITIONAL INFORMATION

If more than one screen, show locations of each on sketch.