

Scott
 P21
 6-19-70

MISSISSIPPI
 BOARD OF WATER COMMISSIONERS
 416 North State Street
 Jackson, Mississippi 39201

CODED

WATER WELL DRILLERS LOG

June 19 1970 date well completed
 Wilkerson Drilling Serv. firm name
 Scott county well located

LANDOWNER: Shadie Moore

description of formations encountered	from	to
Red - yellow Sand	0	30
Blue Clay	30	70
Layers of Rock	70	84
Blue Clay	84	155
Sandy "	155	280
Block Layers	280	305
Rock	305	335
Sandy	335	410
Shale & Sandy	410	565
Water Sand	565	593

Pulaski Miss
 (mailing address)

WELL LOCATION:
 sec. 3 T. 5 R. 4
 3 1/2 miles north of Pulaski
 (distance) (direction) (nearest town)

WELL PURPOSE: Home
 (home, irrigation, municipal, industrial)

- WELL COMPLETION DATA:
- diameter (inches) 2"
 - total depth (feet) 593'
 - static water level (feet) 155' below top of ground.
 - casing galv. (material), 593' (depth)
 if telescope see back.
 (size)
 - screen 5' (length), 593' (depth to top)
2" (size), Stainless Steel (material)
 - pump 1 1/2 (HP), 6 (yield gpm)
elec. (type power)
 - electric log no (yes or no)
 (organization running log)
 - how well bottom plugged 2" B.W.D.

CODED


JUN 30 1970

MISS. BD. OF WATER COMM.

DRILLERS REMARKS:

If well telescopes please sketch and show depths.

GROUND LEVEL

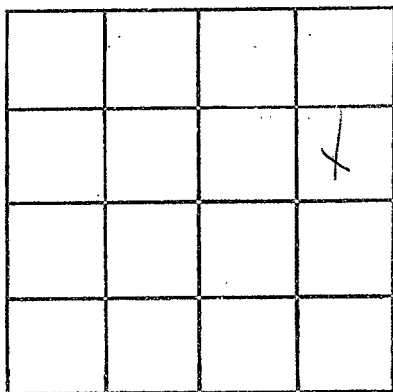

SECTION _____

Please indicate well location X.

ADDITIONAL INFORMATION

If more than one screen, show locations of each on sketch.