

SCOTT
P 22
1-2-63

MISSISSIPPI BOARD OF WATER COMMISSIONERS

WATER WELL DRILLERS LOG

7, CODED

Date: Jan 2, 1963, Driller: Roy Wilkerson County: Scott
(Name)

- (1) Owner of Land: Manning Wicker
(Name)
Lake, Miss
(Address)
- (2) Location: 1/4, 1/4, Sec. 36 58
T-R-
18 miles S.W. of Lake
(distance) (direction) (Nearest Town)
- (3) Topography: 1
(Hilly) (Flat) (Level)
- (4) Purpose of Well: Domestic
(Domestic Irrigation
Municipal, Industrial, Other)

Description & Color of Materials Sand, Clay, Red Clay, Shell, etc.	Thick- ness Feet	Depth Feet
yellow clay	20	
Blue Clay	150	
Sandy - off	80	
Rocky	30	
Sand	36	

Information upon completion of well:


- (1) Diameter 2 inches.
- (2) Total Depth 336 feet.
- (3) Water Level 65 feet below top of ground.
- (4) Cased to 336, Size 2
- (5) Screen: Size 2", Length 6'
- (6) Were any formations sealed against pollution?
yes, 14 - no.

If YES depth of formation _____

Why _____

Drillers Remarks: _____

CODED

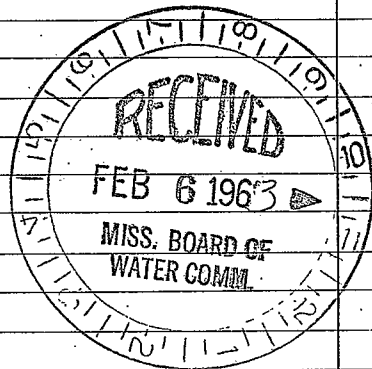

(Use Back Side)

Well No.

