

P 30
 SCOTT
 8-29-85

MISSISSIPPI
 BOARD OF WATER COMMISSIONERS
 416 North State Street
 Jackson, Mississippi 39201

CODED

WATER WELL DRILLERS LOG


8-29-85 Griner Drilling Service, Inc. Scott
 date well completed firm name county well located

LANDOWNER:	description of formations encountered	from	to
(mailing address)			
Transco Exploration P.O. Box 1396 Houston, TX 77001	clay, gumbo, rocks	0	235
WELL LOCATION: 408' S + 526' W of No. 1 sec. 24 T 5 N R. 8 E NE 1/4 E.L. Youngblood Otho Field miles of (nearest town)	SAND CODED	235	294
WELL PURPOSE: oilfield supply (home, irrigation, municipal, industrial)			
WELL COMPLETION DATA:			
(1) diameter (inches) 4"			
(2) total depth (feet) 294'			
(3) static water level (feet) 70' below top of ground.			
(4) casing steel 294' (material) (depth) 4" (size) if telescope see back.			
(5) screen 42' 252' (length) (depth to top) 4" perforated (size) (material)			
(6) pump - 70-75 (HP) (yield gpm) AC (type power)			
(7) electric log (yes or no) <input checked="" type="radio"/>			
(organization running log)			
(8) how well bottom plugged orange pee			
DRILLERS REMARKS:			

RECEIVED
 SEP 23 1985

If well telescopes please sketch and show depths.

GROUND LEVEL

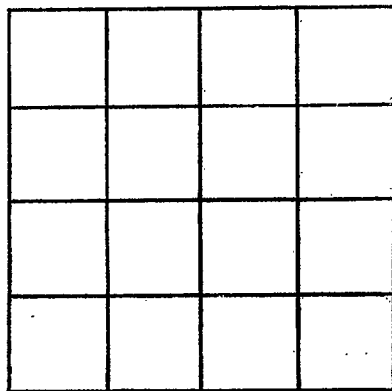

SECTION _____

Please indicate well location X.

ADDITIONAL INFORMATION

If more than one screen,
show locations of each on sketch.