

MISSISSIPPI DEPARTMENT OF NATURAL RESOURCES

Bureau of Land and Water Resources

Southport Mall

P.O. Box 10631

Jackson, Mississippi 39209

WATER WELL DRILLERS LOG

Griner Drilling Service, Inc.

Scott

<i>SCOTT</i>
<i>P 31</i>

Coded

date well completed

firm name

county well located

1-22-88

LANDOWNER:
Exeter Drilling Co.
P.O. Box 1478
Houston, TEXAS 77001
(mailing address)


description of formations encountered	from	to
<i>clay, rocks</i>	<i>0</i>	<i>385</i>
<i>sand</i>	<i>385</i>	<i>483</i>

WELL LOCATION: *2113'N + 75'E of*
sec. *18* T *5* N R *8* E SW/4th cor
No. 1 Barber Creek Field
USA (distance) (direction) (nearest town)

WELL PURPOSE: *oilfield rig*
(home, irrigation, municipal, industrial)
supply

WELL COMPLETION DATA:

- (1) diameter (inches) *3"*
- (2) total depth (feet) *483'*
- (3) static water level (feet) *80'* below above top of ground.
- (4) casing *steel*, *441'*
(material) (depth)
3" if telescope see back.
(size)
- (5) screen *42'*, *399'*
(length) (depth to top)
3" perforated
(size) (material)
- (6) pump *—*, *80*
(HP) (yield gpm)
AC
(type power)
- (7) electric log *—* yes no
(organization running log)
- (8) how well bottom plugged *orange*
peel

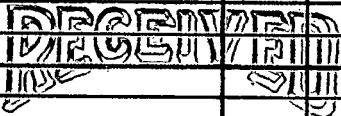

FEB 01 1988

Department of Natural Resources
Bureau of Land & Water Resources

DRILLERS REMARKS:

If well telescopes please sketch and show depths.

GROUND LEVEL

X			

SECTION _____

Please indicate well location X.

ADDITIONAL INFORMATION

If more than one screen,
show locations of each on sketch.