

MISSISSIPPI DEPARTMENT OF NATURAL RESOURCES

Bureau of Land and Water Resources

Southport Mall

P.O. Box 10631

Jackson, Mississippi 39209

WATER WELL DRILLERS LOG

Scott CODED  
P 32  
8-11-88

8-11-88 Griner Drilling Service, Inc. Scott

date well completed

firm name

county well located

LANDOWNER:	description of formations encountered	from	to
<u>Huseman Oil &amp; Royalty</u> <u>P.O. Drawer D</u> <u>Natchez, Ms. 39120</u> (mailing address)	<u>CLAY, ROCK, SAND</u> <u>mostly clay</u>	<u>0</u>	<u>336</u>
WELL LOCATION: <u>500N + 833W</u> of sec <u>8</u> T <u>5</u> (N) R <u>8</u> (E) SE/40R <u>No. 1 Barber E. Barber</u> <u>16 F. Barber</u> <u>Ch. Field</u> (distance) miles (direction) of (nearest town)	<u>SAND</u>	<u>336</u>	<u>400</u>
WELL PURPOSE: <u>oilfield rig</u> (home, irrigation, municipal, industrial)			
WELL COMPLETION DATA:			
(1) diameter (inches) <u>3"</u>			
(2) total depth (feet) <u>400'</u>			
(3) static water level (feet) <u>110'</u> <u>below</u> above top of ground.			
(4) casing <u>PVC</u> , <u>400'</u> (material) (depth)			
<u>3"</u> (size) if telescope see back.			
(5) screen <u>40'</u> , <u>360'</u> (length) (depth to top)			
<u>3"</u> <u>perforated</u> (size) (material)			
(6) pump <u>—</u> <u>75</u> (HP) (yield gpm)			
<u>AC</u> (type power)			
(7) electric log <u>—</u> (yes or no)			
(organization running log)			
(8) how well bottom plugged <u>4" PVC Backwash</u> <u>valve</u>			
DRILLERS REMARKS:			


RECEIVED

AUG 22 1988

Department of Natural Resources  
Bureau of Land & Water Resources

If well telescopes please sketch and show depths.

GROUND LEVEL

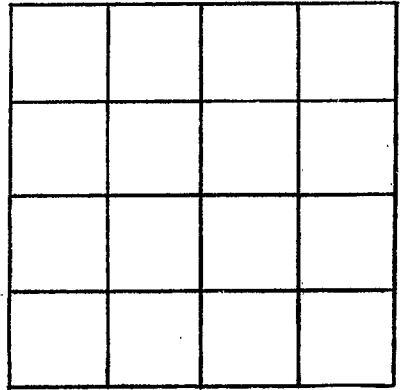

SECTION \_\_\_\_\_

Please indicate well location X.

ADDITIONAL INFORMATION

If more than one screen, show locations of each on sketch.