

SCOTT
P 2001
9-80

MISSISSIPPI
BOARD OF WATER COMMISSIONERS
416 North State Street
Jackson, Mississippi 39201

WATER WELL DRILLERS LOG

Sept 1980 date well completed Wilkerson Drilling firm name Scott county well located

LANDOWNER: Joseph Chodunp
1 Ark Miss (mailing address)

description of formations encountered	from	to
yellow clay	0	10
Blue clay	10	375
sand shale	375	380
sand	380	420

WELL LOCATION:
sec. 2 T. 5 N R. 5 E
3 1/2 miles NE of Hornwood
(distance) (direction) (nearest town)

WELL PURPOSE: home
(home, irrigation, municipal, industrial)

- WELL COMPLETION DATA:
- (1) diameter (inches) 2"
 - (2) total depth (feet) 420
 - (3) static water level (feet) 70 ^{below} above top of ground.
 - (4) casing GALV, 4 1/2" (material) (depth)
(size) If telescope see back.
 - (5) screen 5' 4 1/2" (length) (depth to top)
2" S. Steel (size) (material)
 - (6) pump 1 1/2 HP 7 (yield gpm)
Elec (type power)
 - (7) electric log NO (yes or no)
 - (organization running log)
 - (8) how well bottom plugged 2" BWU

DRILLERS REMARKS:


DEPT. OF NATURAL RESOURCES
BUREAU OF LAND & WATER RESOURCES

DEC - 1 1980

RECEIVED

If well telescopes please sketch and show depths.

GROUND LEVEL

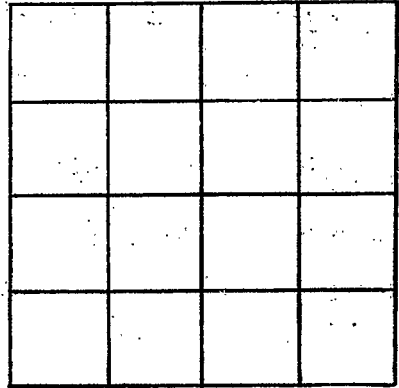

SECTION _____

Please indicate well location X.

ADDITIONAL INFORMATION

If more than one screen, show locations of each on sketch.