

MISSISSIPPI DEPARTMENT OF NATURAL RESOURCES

Bureau of Land and Water Resources

P.O. Box 10631

Jackson, Mississippi 39209

WATER WELL DRILLERS LOG

COUNTY WELL LOCATED <i>Scott</i>	
WELL NUMBER <i>P</i>	CODED
DATE WELL COMPLETED <i>2003 10-11-91</i>	

PERMIT NUMBER
NAME OF DRILLING FIRM <i>THOMAS</i>

NAME & MAILING ADDRESS OF LANDOWNER <i>Jimmy Moore At. 2 Box 260 Forest, MS 39074</i>			
WELL LOCATION: SEC	TOWNSHIP	RANGE	
<i>13</i>	<i>5</i>	<i>N</i> <i>S</i>	<i>8</i> <i>W</i>
DISTANCE	DIRECTION	NEAREST TOWN	
<i>3</i> Miles	<i>W</i>	<i>Sherman</i>	
OTHER LANDMARK <i>1 mile S of Church</i>			
WELL PURPOSE: Home, Irrigation, Municipal, Industrial, Fish Pond, etc.			

PUMP DATA		
PUMP TYPE (Circle One): Submersible, Turbine, Jet, Flowing Well, Other (Describe) <i>Air Well</i>		
POWER TYPE (Circle One): <i>Electric</i> , Tractor, Diesel, Gasoline, Butane, Other (Describe) _____ H/P _____		
Pump Capacity (GPM)	No. of Stages	Setting Depth
<i>owner supplied pump</i> _____ FT.		
PUMP TEST		
Well yielded <i>20</i> GPM with		
a drawdown of <i>20</i> ft.		
after <i>1</i> hours of pumping		

WELL DATA		
Well Depth <i>360</i>	Casing Diameter (In.) <i>2</i>	Casing Length (Ft.) <i>340'</i>
Type of Casing <i>PVC</i>	Hole Depth <i>360</i>	Depth to Static Water Level <i>50'</i>
TYPE OF COMPLETION: (Circle One or More): <i>Gravel Packed</i> , Underreamed, Telescoped, Natural Development, Open Hole, Other		
Top of Lap Pipe or Reduction in Casing <i>—</i> FEET		
IF TELESCOPED OR MORE THAN ONE SCREEN: USE BACK PAGE		

LOG DATA	
TYPE OF LOG RUN (Circle One): <i>No Log Run</i> , Electric, Gamma Ray, Density, Sonic, Neutron, Other (Describe) _____	
Name of Organization Running Log	


SCREEN DATA		
Diameter - Inches <i>2</i>	Length - Feet <i>20</i>	Slot Size - Inches <i>10</i>
Screen Type <i>PVC</i>	Depth to Bottom - Feet <i>360</i>	

GEOLOGIC DATA (Office Use Only)			
Surface Elev.	Geologic Unit	Unit Thickness	Depth to Top
Subs. SWL	Date	Analysis	Aquifer Test
Driller's Remarks			

DESCRIPTION OF FORMATIONS ENCOUNTERED	FROM	TO	FORMATIONS (Continued)	FROM	TO
<i>Brown dirt</i>	<i>0</i>	<i>10</i>	RECEIVED		
<i>Gray Clay</i>	<i>10</i>	<i>320</i>			
<i>Gray Sand</i>	<i>320</i>	<i>360</i>			
			NOV 25 1991		
			Dept. of Environmental Quality Bureau of Land & Water Resources		
IF MORE SPACE IS NEEDED, USE BACK					

If well telescopes please
sketch and show depths.

GROUND LEVEL

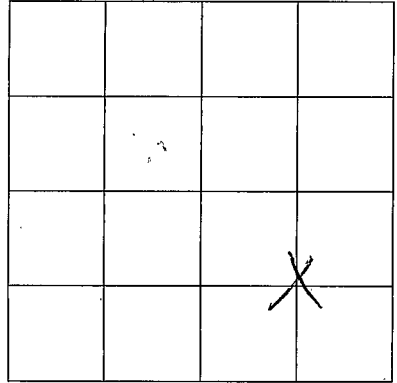

SECTION _____

Please indicate well location X.

ADDITIONAL INFORMATION

Lined area for additional information.

If more than one screen,
show location of each on sketch.