

SCOTT MISSISSIPPI BOARD OF WATER COMMISSIONERS

WATER WELL DRILLERS LOG

Q2
10-12-62

3

Date: 10-12, 1962, Driller: LEACH County: SCOTT

(Name)

- (1) Owner of Land: W. F. W. POOT, 4974
(Name)
LAKE MISS
(Address)
- (2) Location: 1/4, 1/4, Sec. 4 T R
5 miles SW of LAKE
(distance) (direction) (Nearest Town)
- (3) Topography: FLAT
(Hilly) (Flat) (Level)
- (4) Purpose of Well: DOMESTIC
(Domestic Irrigation
 Municipal, Industrial, Other)

Description & Color of Materials
 Sand, Clay, Red Clay, Shell, etc.

Thick-
ness
Feet

Depth
Feet

GUMMEY CLAY	30	
BLUE CLAY	75	105
SHELL + ROCK	30	135
SAND	45	175


Information upon completion of well:

- (1) Diameter 2 inches.
- (2) Total Depth 175 feet.
- (3) Water Level 100 feet below top of ground.
- (4) Cased to 175, Size 2"
- (5) Screen: Size 2", Length 6"
- (6) Were any formations sealed against pollution?
no yes, no

If YES depth of formation _____

Why _____

Drillers Remarks: _____

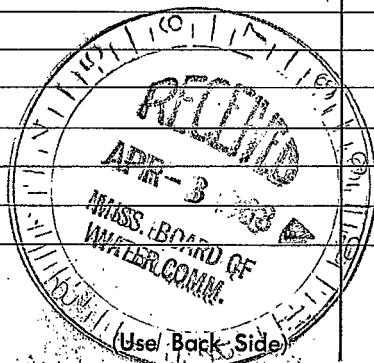

Well No.

