

WATER WELL DRILLERS LOG

Date: Mar. 19 1966, Driller: Roy Wilkinson County Scott  
 (Name)

(1) Owner of Land: Huffman Moore  
 (Name)  
Lake, Miss  
 (Address)

(2) Location: 1/4, 1/4, Sec. 22 5th 7E  
6 miles S. of Lake  
 (distance) (direction) (Nearest Town)

(3) Topography: Flat  
 (Hilly) (Flat) (Level)

(4) Purpose of Well: Domestic  
 (Domestic Irrigation  
 Municipal, Industrial, Other)

Description & Color of Materials Sand, Clay, Red Clay, Shell, etc.	Thick- ness Feet	Depth Feet
<u>Sandy top soil</u>	<u>20</u>	
<u>blue clay</u>	<u>280</u>	
<u>Rocky</u>	<u>100</u>	
<u>water stand</u>	<u>34</u>	
<u>Total</u>		<u>434</u>

Information upon completion of well:

(1) Diameter 2 inches.

(2) Total Depth 434 feet.

(3) Water Level 40 feet below top of ground.

(4) Cased to 434, Size 2


(5) Screen: Size 2, length 4

(6) Were any formations sealed against pollution?  
 \_\_\_\_\_ yes, \_\_\_\_\_ no.

If YES depth of formation \_\_\_\_\_

Why \_\_\_\_\_

Drillers Remarks: \_\_\_\_\_

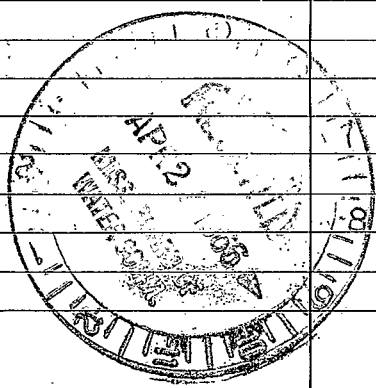

(Use Back Side)

Well No.

