

CODED

MISSISSIPPI
BOARD OF WATER COMMISSIONERS
416 North State Street
Jackson, Mississippi 39201

WATER WELL DRILLERS LOG

Scott
Q 4
1-69

JAN 25 19 69 Wilkerson Drilling 82894
date well completed firm name county well located

LANDOWNER: Tim Sanders

description of formations encountered from to

Forest Miss
(mailing address)

yellow clay 0 30
Blue clay 30 280
Rock 280 284
SAND FIN 284 297
Brown shale 297 310
SAND 310 370

WELL LOCATION:
sec 29 T 5 N R 9 E
6 miles N of Pineville
(distance) (direction) (nearest town)

WELL PURPOSE: home
(home, irrigation, municipal, industrial)

WELL COMPLETION DATA:

- (1) diameter (inches) 2"
- (2) total depth (feet) 367
- (3) static water level (feet) 85 below above top of ground.
- (4) casing GALV, 361 (material) (depth)
If telescope see back. (size)
- (5) screen 6, 367 (length) (depth to top)
2", STAINLESS Steel (size) (material)
- (6) pump 2, 12 (HP) (yield gpm)
Elec (type power)
- (7) electric log No (yes or no)
(organization running log)
- (8) how well bottom plugged 2" P.W.U.

CODED

MAR 4 1969


DRILLERS REMARKS:

MISS. BD. OF
WATER COMM.

If well telescopes please sketch and show depths.

GROUND LEVEL

310 375 SAND
310 310 BROWN SAND
310 284 SAND FINE
310 280 ROCK
310 278 CLAY
310 270 CLAY
310 260 CLAY
310 250

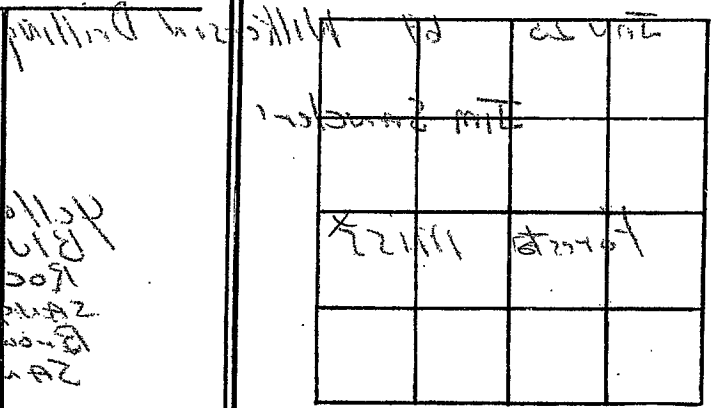

SECTION 29

Please indicate well location X.

ADDITIONAL INFORMATION

1
3/2
22
CORN 3/1
1 3/1
2 3/1
15
3/1
No
3/1

If more than one screen, show locations of each on sketch.