

Scott
Q5
6-69

MISSISSIPPI
BOARD OF WATER COMMISSIONERS
416 North State Street
Jackson, Mississippi 39201

CODED

WATER WELL DRILLERS LOG

JUNE 19 69 date well completed
LAKA firm name
SCOTT county well located

LANDOWNER:

Mr Bill Jones
Forest MISS
(mailing address)

description of formations encountered from to

Red SAND + Rock	0	50
Blue CLAY	50	150
Rock + clay	150	170
Blue shale	170	300
Brown shale	300	350
Fine SAND	350	380
Co. of SAND	380	420

WELL LOCATION:

sec. 2 T. 5 N R. 9 E
S W
6 1/2 miles S of Forest
(distance) (direction) (nearest town)

WELL PURPOSE:

home
(home, irrigation, municipal, industrial)

WELL COMPLETION DATA:

- (1) diameter (inches) 2
- (2) total depth (feet) ~~180~~ 403
- (3) static water level (feet) 180 below above top of ground.
- (4) casing GALV, 399,
(material) (depth)
2 if telescope see back.
(size)
- (5) screen 4, 403
(length) (depth to top)
2, STAINLESS Steel
(size) (material)
- (6) pump 3, 9
(HP) (yield gpm)
ELC
(type power)
- (7) electric log NO
(yes or no)
(organization running log)
- (8) how well bottom plugged 2 ROCK


JUN 30 1969

MISS. BD. OF
WATER COMM.

DRILLERS REMARKS:

If well telescopes please sketch and show depths.

GROUND LEVEL

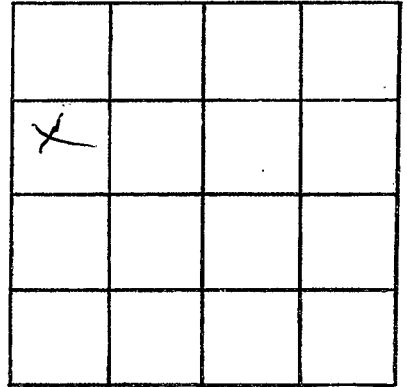

SECTION 2

Please indicate well location X.

ADDITIONAL INFORMATION

If more than one screen,
show locations of each on sketch.