

MISSISSIPPI
BOARD OF WATER COMMISSIONERS
416 North State Street
Jackson, Mississippi 39201

CODED

WATER WELL DRILLERS LOG

Scott
Q 6
1-70

Jan 1970 date well completed Wilkegan firm name Scott county well located

LANDOWNER: R. F. Bonds

description of fomations encountered

from to

Forest Mills
(mailing address)

Red clay 0 10
yellow 10 25
sand & clay 25 45
blue elk 45 180
shale & rock 180 210
SAND 210 380

WELL LOCATION:

sec. 17 T 5 N R 9 E
10 miles S.W. of Lake
(distance) (direction) (nearest town)

WELL PURPOSE: home
(home, irrigation, municipal, industrial)

WELL COMPLETION DATA:

- (1) diameter (inches) 2
- (2) total depth (feet) 300
- (3) static water level (feet) 138 below top of ground.
- (4) casing Galv, 296, (material), (depth),
if telescope see back.
(size)
- (5) screen 4, 800 (length), (depth to top)
2, stainless (size), (material)
- (6) pump 3, 12 (HP), (yield gpm)
Elec (type power)
- (7) electric log NO (yes or no)

(organization running log)

(8) how well bottom plugged 2BWU

MAR 10 1970


DRILLERS REMARKS:

MISS. BD. OF
WATER COMM.

CODED

If well telescopes please sketch and show depths.

GROUND LEVEL

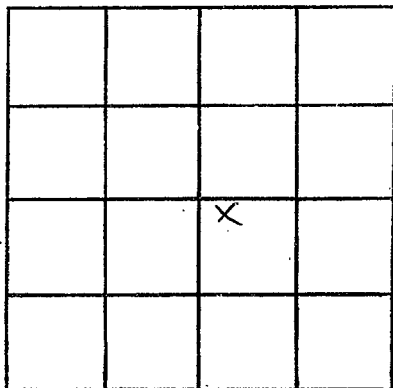

SECTION 17

Please indicate well location X.

ADDITIONAL INFORMATION

If more than one screen,
show locations of each on sketch.