

SCOTT
Q7
8-13-70

MISSISSIPPI
BOARD OF WATER COMMISSIONERS
416 North State Street
Jackson, Mississippi 39201

CODED

WATER WELL DRILLERS LOG

8/13 1970 Forest Drilling Scott
date well completed firm name county well located

LANDOWNER:

C. R. Barrett
Lake, Miss.
(mailing address)

description of formations encountered

from to

| | | |
|------------------------|-----|-----|
| Brown clay | 0 | 17 |
| Sand | 17 | 24 |
| Blue clay | 24 | 81 |
| Clay + shaly limestone | 81 | 122 |
| Clay | 122 | 140 |
| Mucky sand | 140 | 143 |
| Clay + fine sand | 143 | 163 |
| Fine sand | 163 | 174 |
| Fine sand | 174 | 222 |
| Fine sand + clay | 222 | 245 |

WELL LOCATION:

sec. 5 T 5 N R 9 E
7 miles SE of Forest
(distance) (direction) (nearest town)

WELL PURPOSE: none
(home, irrigation, municipal, industrial)

WELL COMPLETION DATA:

- (1) diameter (inches) 2"
- (2) total depth (feet) 227'
- (3) static water level (feet) 120' below top of ground.
- (4) casing Steel 217' (material) (depth)
2" (size) if telescope see back.
- (5) screen 10' 217' (length) (depth to top)
2" Brass CI (size) (material)
- (6) pump Be Omer (HP) (yield gpm)
(type power)
- (7) electric log no (yes or no)
(organization running log)
- (8) how well bottom plugged 2" Backwash Valve

CODED


AUG 27 1970

DRILLERS REMARKS:

MISS. BD. OF
WATER COMM.

If well telescopes please sketch and show depths.

GROUND LEVEL

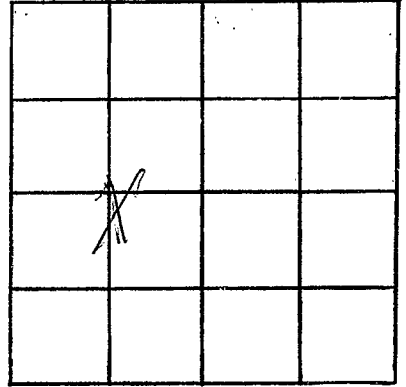

SECTION 5

Please indicate well location X.

ADDITIONAL INFORMATION

If more than one screen,
show locations of each on sketch.