

MISSISSIPPI
BOARD OF WATER COMMISSIONERS
416 North State Street
Jackson, Mississippi 39201

CODED

WATER WELL DRILLERS LOG

SCOTT
Q8
2-24-71

Feb 24 1971 Wilkinson Drilling Serv. Scott
date well completed firm name county well located

LANDOWNER: Jalileo Baptist Church
Lake, Miss
(mailing address)

description of formations encountered	from	to
Red sand	0	15
Brown sand	15	25
Blue clay	25	300
Rocky + shale	300	400
water sand	400	420

WELL LOCATION:
sec. 33 T. 5 N R. 9 E
9. miles S. of Lake
(distance) (direction) (nearest town)

WELL PURPOSE: Chuck
(home, irrigation, municipal, industrial)

WELL COMPLETION DATA:

- (1) diameter (inches) 2"
- (2) total depth (feet) 420
- (3) static water level (feet) 158 below above top of ground.
- (4) casing Galv. 400'
(material) (depth)
 if telescope see back.
(size)
- (5) screen 20'
(length) (depth to top)
2 Brass
(size) (material)
- (6) pump 1 1/2 HP. 15
(HP) (yield gpm)
Elec.
(type power)
- (7) electric log no
(yes or no)

(organization running log)
- (8) how well bottom plugged B, W, V.

CODED


MAR 4 - 1971

MISS. SD. OF
WATER COMMISSIONERS

DRILLERS REMARKS:

If well telescopes please sketch and show depths.

GROUND LEVEL

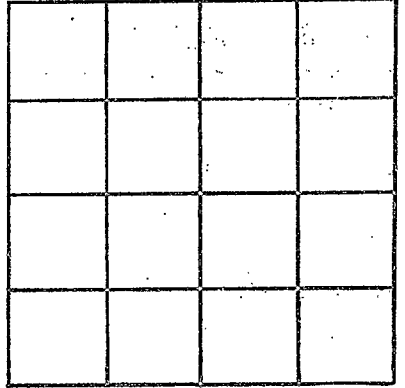

SECTION _____

Please indicate well location X.

ADDITIONAL INFORMATION

If more than one screen, show locations of each on sketch.