

Scott
Q 10
6-9-75

MISSISSIPPI
BOARD OF WATER COMMISSIONERS
416 North State Street
Jackson, Mississippi 39201

CODED

WATER WELL DRILLERS LOG

6-9-75 date well completed 1975 Wilkinson Drilling Service firm name Scott county well located

LANDOWNER:
Rosie G. Burges
LAKE MISS
(mailing address)

description of formations encountered	from	to
yellow clay	0	20
blue clay	20	189
clay + sand	189	225
sand	225	258

WELL LOCATION:
sec. 15 T 6 N R 9 E 13E
3 miles SW of Lake
(distance) (direction) (nearest town)

WELL PURPOSE:
(home, irrigation, municipal, industrial)

WELL COMPLETION DATA:

(1) diameter (inches) 2

(2) total depth (feet) 258

(3) static water level (feet) 60 below top of ground.

(4) casing GALV 253 (material) (depth)

(size) If telescope see back.

(5) screen 5' 258 (length) (depth to top)

(size) (material) Stainless Steel


(6) pump 2 12 (HP) (yield gpm)

(type power) Elec

(7) electric log No (yes or no)

(organization running log)

(8) how well bottom plugged B.W.V.

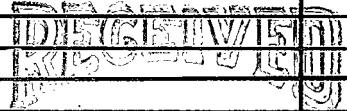


JUN - 9 1975

DRILLERS REMARKS:

If well telescopes please sketch and show depths.

GROUND LEVEL

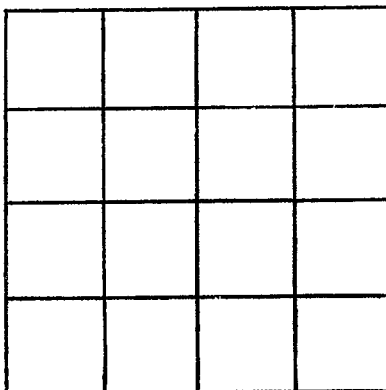

SECTION _____

Please indicate well location X.

ADDITIONAL INFORMATION

If more than one screen, show locations of each on sketch.