

MISSISSIPPI  
 BOARD OF WATER COMMISSIONERS  
 416 North State Street  
 Jackson, Mississippi 39201

WATER WELL DRILLERS LOG

D-11  
6-4-80

date well completed 6-4-80 firm name Greiner Drilling county well located Scott

LANDOWNER:  
Union Oil of California  
325 Cottage Hill Road  
Mobile, Ala. 36616  
 (mailing address)

description of formations encountered	from	to
clay	0	224
sand & clay	224	245
clay & sand	245	308
clay & shell	308	350
clay & rocks	350	372
rock & sand	372	473
sand	473	497

WELL LOCATION: 2024 N + 245 W  
23 T 50 S R 9 E of  
Weems Lake of 8 1/2 mi  
 (distance) (direction) (nearest town)

*No! Mack's Weems Lake 2.5 mi*

WELL PURPOSE: oil field supply  
 (home, irrigation, municipal, industrial)

- WELL COMPLETION DATA:
- (1) diameter (inches) 3"
  - (2) total depth (feet) 497'
  - (3) static water level (feet) 175' <sup>below</sup> above top of ground.
  - (4) casing steel, 483'  
 (material) (depth)  
3"  
 (size) if telescope see back.
  - (5) screen 42', 441'  
 (length) (depth to top)  
3", perforated  
 (size) (material)
  - (6) pump 70  
 (HP) (yield gpm)  
AC  
 (type power)
  - (7) electric log             
 (yes or no)

(organization running log)

(8) how well bottom plugged orange  
peel


DRILLERS REMARKS:

DEPT. OF NATURAL RESOURCES  
 BUREAU OF LAND & WATER RESOURCES

JUN 19 1980  
 RECEIVED

If well telescopes please sketch and show depths.

GROUND LEVEL

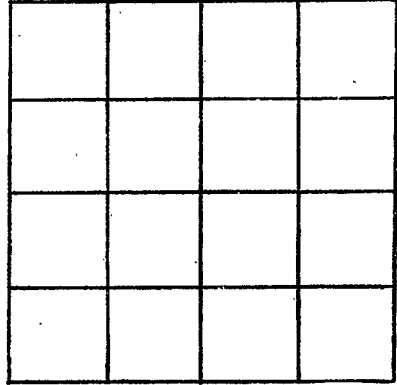

SECTION \_\_\_\_\_

Please indicate well location X.

ADDITIONAL INFORMATION

If more than one screen, show locations of each on sketch.