

MISSISSIPPI DEPARTMENT OF NATURAL RESOURCES

Bureau of Land and Water Resources

Southport Mall

P.O. Box 10631

Jackson, Mississippi 39209

WATER WELL DRILLERS LOG

CODED

SCOTT
 Q 12
 8-22-82

Griner Drilling Service, Inc. Scott

8-22-82 date well completed

Griner Drilling Service, Inc. firm name

Scott county well located

LANDOWNER:	description of formations encountered	from	to
(mailing address)			
Murco Drilling 1908 Beck Bldg. Shreveport, La. 71101	chalk	0	84
WELL LOCATION: 824'S + 2050'E Sec. 19 T. 5N R. 9E of NW/4	chalk, rock	84	147
No. 1 G. L.iston H. A.iston miles of (direction) of (nearest town)	chalk	147	231
WELL PURPOSE: oil field supply	sand CODED	231	378
(home, irrigation, municipal, industrial)	chalk	378	426
WELL COMPLETION DATA:			
(1) diameter (inches) 3"			
(2) total depth (feet) 420'			
(3) static water level (feet) 45' below top of ground			
(4) casing Steel 378' (material) (depth)			
3" (size) if telescope see back.			
(5) screen 42' 336' (length) (depth to top)			
3" perforated (size) (material)			
(6) pump 75 (HP) (yield gpm)			
AC (type power)			
(7) electric log NO (yes or no)			
(organization running log)			
(8) how well bottom plugged orange			
peel			
DRILLERS REMARKS:			


DEPT. OF NATURAL RESOURCES
 BUREAU OF LAND & WATER RESOURCES

AUG 26 1982

RECEIVED

If well telescopes please
sketch and show depths.

GROUND LEVEL

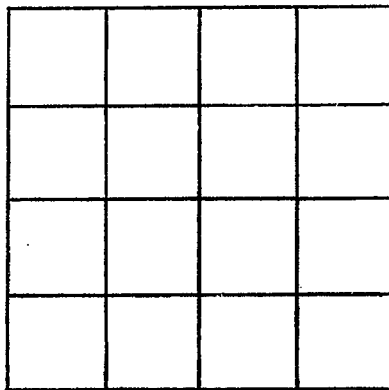

SECTION _____

Please indicate well location X.

ADDITIONAL INFORMATION

If more than one screen,
show locations of each on sketch.