

MISSISSIPPI DEPARTMENT OF NATURAL RESOURCES

Bureau of Land and Water Resources

Southport Mall

P.O. Box 10631

Jackson, Mississippi 39209

WATER WELL DRILLERS LOG **CODED**

*Griner Drilling Service, Inc.*

*Scott*

Q13  
Scott, Co.  
11-7-83

11-7-83  
date well completed

Griner Drilling Service, Inc.  
firm name

Scott  
county well located

LANDOWNER:

*MURCO Drilling*  
*1908 Beck Bldg*  
*Shreveport, La 71101*  
(mailing address)

description of formations encountered

from

to

*chalk, rock*

*0 284*

*SAND*

*284 357*

WELL LOCATION: *1830'S + 785'E*

sec. *19* T. *50* N. R. *9* E. NW1/4

*No. 1 W.M. Eichelberger* miles of *Otho Field* (nearest town)

*SW1/4, NW1/4*

WELL PURPOSE: *oilfield supply*  
(home, irrigation, municipal, industrial)

WELL COMPLETION DATA:

(1) diameter (inches) *4"*

(2) total depth (feet) *357'*

(3) static water level (feet) *20'* <sup>below</sup> <sub>above</sub> top of ground.

(4) casing *steel*, *357'*  
(material) (depth)

*4"*  
(size) if telescope see back.

(5) screen *42'*, *315'*  
(length) (depth to top)

*4"*, *perforated*  
(size) (material)

(6) pump *—*, *80-85*  
(HP) (yield gpm)

*AC*  
(type power)

(7) electric log *—*  
(yes or no)

*—*  
(organization running log)

(8) how well bottom plugged *orange*  
*peet*

DRILLERS REMARKS:

**CODED**


DEPT. OF NATURAL RESOURCES  
BUREAU OF LAND & WATER RESOURCES

NOV 29 1983

RECEIVED

If well telescopes please sketch and show depths.

GROUND LEVEL

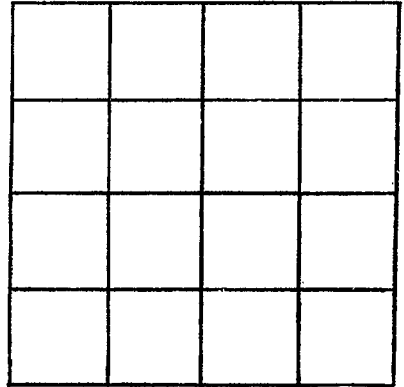

SECTION \_\_\_\_\_

Please indicate well location X.

ADDITIONAL INFORMATION

If more than one screen,  
show locations of each on sketch.