

MISSISSIPPI DEPARTMENT OF NATURAL RESOURCES

Bureau of Land and Water Resources

Southport Mall

P.O. Box 10631

Jackson, Mississippi 39209

CODED

WATER WELL DRILLERS LOG

SCOTT
Q 14

Griner Drilling Service, Inc.

SCOTT

10-30-84 date well completed

Griner Drilling Service, Inc. firm name

SCOTT county well located

LANDOWNER:
Marion Drilling
P.O. Box 3027
Daphne, Alabama 36526
(mailing address)

description of formations encountered	from	to
clay	0	273
sand	273	357
clay, rocks	357	672

WELL LOCATION: 1624'S + 997'E
sec. 19 T. 50 N R. 9 E of NW 1/4
No. 1 Eichelberger Oil Field
Lee (distance) (direction) (nearest town)

WELL PURPOSE:
(home, irrigation, municipal, industrial)

CODED

WELL COMPLETION DATA:

- (1) diameter (inches) 3"
- (2) total depth (feet) 672'
- (3) static water level (feet) 50' ^{below} _{above} top of ground.
- (4) casing steel 357'
(material) (depth)
- 3"
(size) if telescope see back.
- (5) screen 42' 315'
(length) (depth to top)
- 3" perforated
(size) (material)
- (6) pump - 80
(HP) (yield gpm)
- AC
(type power)
- (7) electric log (yes or no) (no)

(organization running log)

(8) how well bottom plugged orange peel

DRILLERS REMARKS:


DEPT. OF NATURAL RESOURCES
BUREAU OF LAND & WATER RESOURCES

NOV 14 1984

RECEIVED

If well telescopes please
sketch and show depths.

GROUND LEVEL

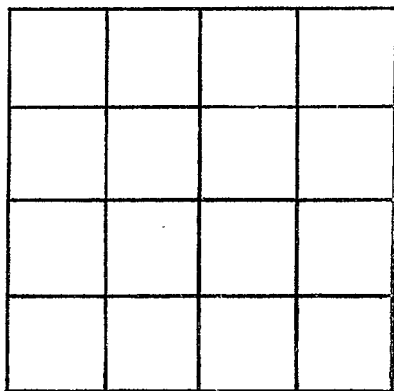

SECTION _____

Please indicate well location X.

ADDITIONAL INFORMATION

If more than one screen,
show locations of each on sketch.