

SCOTT

Q 15

MISSISSIPPI DEPARTMENT OF NATURAL RESOURCES
 Bureau of Land and Water Resources
 Southport Mall
 P.O. Box 10631
 Jackson, Mississippi 39209
 WATER WELL DRILLERS LOG

CODED

4-18-85 Griner Drilling Service, Inc.

Scott

date well completed

firm name

county well located


LANDOWNER:	description of formations encountered	from	to
Marion Drilling P.O. Box 3027 One Marion Avenue Mobile, (mailing address) Alabama 36682 sec. 18 T. 50N R. 9 E SW/4 of Huseman Oil & Royalty Ocho Fields (distance) miles (direction) of (nearest town) Notelberger WELL PURPOSE: oilfield supply (home, irrigation, municipal, industrial)			
WELL COMPLETION DATA:			
(1) diameter (inches) <u>3'</u>			
(2) total depth (feet) <u>420'</u>			
(3) static water level (feet) <u>60'</u> <input checked="" type="checkbox"/> below <input type="checkbox"/> above top of ground.			
(4) casing <u>steel 378'</u> (material) (depth)			
<u>3"</u> (size) if telescope see back.			
(5) screen <u>42'</u> <u>336'</u> (length) (depth to top)			
<u>3"</u> <u>perforated</u> (size) (material)			
(6) pump <u>—</u> <u>80</u> (HP) (yield gpm)			
<u>AC</u> (type power)			
(7) electric log <input checked="" type="checkbox"/> (yes or no)			
(organization running log)			
(8) how well bottom plugged <u>orange peel</u>			
DRILLERS REMARKS:			

CODED

RECEIVED
 APR 30 1985
 Department of Natural Resources
 Bureau of Land & Water Resources

If well telescopes please
sketch and show depths.

GROUND LEVEL

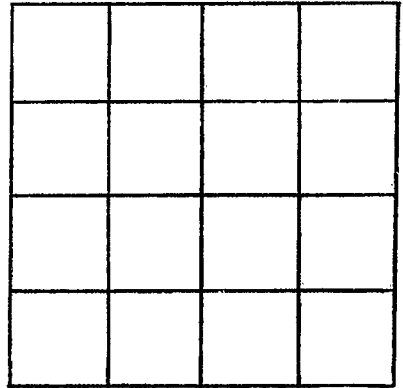

SECTION _____

Please indicate well location X.

ADDITIONAL INFORMATION

If more than one screen,
show locations of each on sketch.