

MISSISSIPPI DEPARTMENT OF NATURAL RESOURCES

Bureau of Land and Water Resources

Southport Mall

P.O. Box 10631

Jackson, Mississippi 39209

WATER WELL DRILLERS LOG

CODED

Scott
Q 16

12-31-85 date well completed Griner Drilling Service, Inc. firm name Scott county well located

LANDOWNER:	description of formations encountered	from	to
Huseman Oil and Royalties, Inc. P.O. Box 19 Natchez, MS 39120 (mailing address)	chalk	0	126
	rock	126	127
WELL LOCATION: 2150' N + 2140' W sec. 19 T. 5 N R. 9 E of No. 1 Lee Otho Field et al (distance) (direction) (nearest town)	chalk	127	168
	SAND	168	208
WELL PURPOSE: oilfield supply (home, irrigation, municipal, industrial)	chalk	208	221
WELL COMPLETION DATA:	SAND	221	357
(1) diameter (inches) 3"	CHALK	357	359
(2) total depth (feet) 359'			
(3) static water level (feet) 60' below top of ground.			
(4) casing steel 357' (material) (depth) 3" (size) If telescope see back.			
(5) screen 4.2' 315' (length) (depth to top) 3" perforated (size) (material)			
(6) pump — 95 (HP) (yield gpm) AC (type power)			
(7) electric log (yes or no) (organization running log)			
(8) how well bottom plugged orange peel			

CODED

RECEIVED


JAN 13 1986

Department of Natural Resources
Bureau of Land & Water Resources

DRILLERS REMARKS:

If well telescopes please
sketch and show depths.

GROUND LEVEL

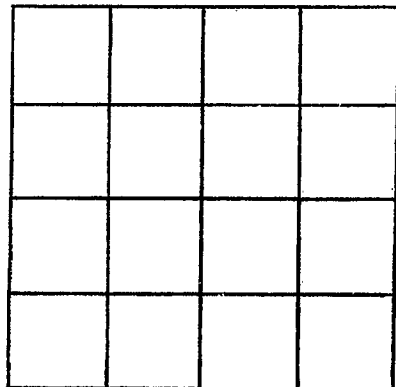

SECTION _____

Please indicate well location X.

ADDITIONAL INFORMATION

If more than one screen,
show locations of each on sketch.