

Scott  
Q 2000  
3-31-77

MISSISSIPPI  
 BOARD OF WATER COMMISSIONERS  
 416 North State Street  
 134 Jackson, Mississippi 39201

WATER WELL DRILLERS LOG

3-31-77 19 Wilkinson Drilling Serv. Scott  
 date well completed firm name county well located

LANDOWNER: Charles Simmons  
Lake, Miss  
Route 2  
 (mailing address)

WELL LOCATION:  
 sec. 21 T 5 N R 9 E  
8 miles S of Lake  
 (distance) (direction) (nearest town)

WELL PURPOSE:  
 (home, irrigation, municipal, industrial)

WELL COMPLETION DATA:

- (1) diameter (inches) 2"
- (2) total depth (feet) 447'
- (3) static water level (feet) 108 below top of ground
- (4) casing galv. 447'  
 (material) (depth)
- (size) if telescope see back.
- (5) screen 11" 8'  
 (length) (depth to top)
- 1" Steel  
 (size) (material)
- (6) pump 3 (HP) (yield gpm)  
elec  
 (type power)
- (7) electric log no  
 (yes or no)

(organization running log)

(8) how well bottom plugged Billiv.

DRILLERS REMARKS:

description of formations encountered	from	to
Sand	0	10'
B. Clay	10'	250'
B. Clay & Rocks	250'	350'
Sand & Rocks	350'	400'
Rock	400'	410'
Sand	410'	447'


**RECEIVED**

APR 28 1977

MISS. BD. OF WATER COMMISSIONERS

If well telescopes please  
sketch and show depths.

GROUND LEVEL

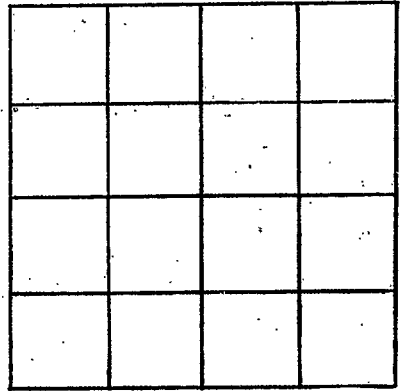

SECTION \_\_\_\_\_

Please indicate well location X.

ADDITIONAL INFORMATION

If more than one screen,  
show locations of each on sketch.