

Scott
 Q 2002
 10/1/79

MISSISSIPPI
 BOARD OF WATER COMMISSIONERS
 416 North State Street
 Jackson, Mississippi 39201

WATER WELL DRILLERS LOG

Oct 15th 1979 date well completed Wilkerson Drilling firm name Scott county well located

LANDOWNER: Jackson Riley
Racine
Forest, Miss
 (mailing address)

description of formations encountered	from	to
Red. Clay	0	10
Yellow clay	10	30
Blue. clay	30	200
Sandy Rocks	200	400
Shale B clay	400	460
water sands	460	467

WELL LOCATION:
 sec. 4 T. 5 N R. 90
~~3~~ miles South of Lake
 (distance) (direction) (nearest town)

WELL PURPOSE: None
 (home, irrigation, municipal, industrial)

- WELL COMPLETION DATA:
- (1) diameter (inches) 2"
 - (2) total depth (feet) 467
 - (3) static water level (feet) 110 below above top of ground.
 - (4) casing Galv. 467
 (material) (depth)
2 if telescope see back.
 (size)
 - (5) screen 5 Foot
 (length) (depth to top)
2 St. Steel
 (size) (material)
 - (6) pump 2 10
 (HP) (yield gpm)
Elec.
 (type power)
 - (7) electric log no
 (yes or no)
- (organization running log)

(8) how well bottom plugged BWU

DRILLERS REMARKS:
MISS Please


DEPT. OF NATURAL RESOURCES
 BUREAU OF LAND & WATER RESOURCES
 MAY 18 1981
RECEIVED

If well telescopes please sketch and show depths.

Miss Ploed

GROUND LEVEL

parallel with

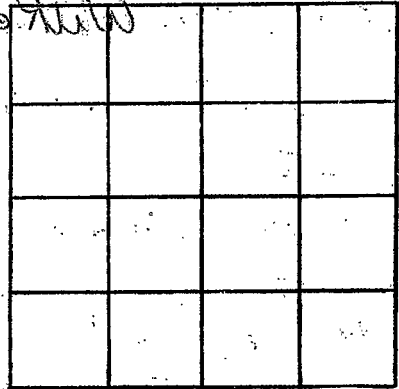

SECTION _____

Please indicate well location X.

ADDITIONAL INFORMATION

If more than one screen, show locations of each on sketch.