

Scott
Q 2005

MISSISSIPPI
BOARD OF WATER COMMISSIONERS
416 North State Street
Jackson, Mississippi 39201

WATER WELL DRILLERS LOG

Sept 1981 date well completed Wilkerson Drilling firm name Scott county well located

LANDOWNER: Bessie Bargin

description of formations encountered	from	to
Red Sand	0	20
Yellow Clay + Sand	20	55
Blue Clay + Sand	55	240
Sand	240	300

LAKE Miss
(mailing address)

WELL LOCATION:
sec 21 T 41 N R 9 E
S W
7 miles South of Lake
(distance) (direction) (nearest town)

WELL PURPOSE: home
(home, irrigation, municipal, industrial)

- WELL COMPLETION DATA:
- (1) diameter (inches) 2"
 - (2) total depth (feet) 300'
 - (3) static water level (feet) 60 below / above top of ground.
 - (4) casing PVC, 290'
(material) (depth)
 - (size) If telescope see back.
 - (5) screen 10', 300'
(length) (depth to top)
 - 2", PVC
(size) (material)
 - (6) pump 2 9
(HP) (yield gpm)
 - Elec
(type power)
 - (7) electric log NO
(yes or no)

(organization running log)

(8) how well bottom plugged _____

DRILLERS REMARKS: _____


DEPT. OF NATURAL RESOURCES
BUREAU OF LAND & WATER RESOURCES

JAN 11 1982

RECEIVED

If well telescopes please sketch and show depths.

GROUND LEVEL

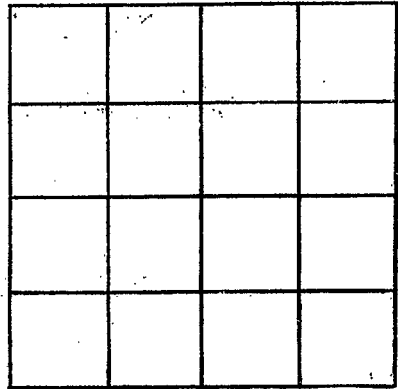

SECTION _____

Please indicate well location X.

ADDITIONAL INFORMATION

If more than one screen, show locations of each on sketch.