

SHARKEY
A 34
9-68
MISS GEO SUR

MISSISSIPPI
BOARD OF WATER COMMISSIONERS
416 North State Street
Jackson, Mississippi 39201

CODED

WATER WELL DRILLERS LOG


9-8 1967 - DAVID BERRY Sharkey
date well completed firm name county well located

LANDOWNER:
G. P. Casselli
NITTA YAMA, Miss
(mailing address)
WELL LOCATION:
sec. 30 T. 14 N R. 6 E
0 miles of NITTA YAMA
(distance) (direction) (nearest town)
WELL PURPOSE: Home
(home, irrigation, municipal, industrial)

description of formations encountered	from	to
CLAY	0	34
SAND	34	96
GRAVEL	96	127
GRAVEL & SAND	127	174
CLAY	174	183
SAND	183	342
SAND-SHALE	342	373
SHALE	373	465
SHALE & SAND	465	549
SAND	549	700

WELL COMPLETION DATA:
(1) diameter (inches) 4 X 3
(2) total depth (feet) 700
(3) static water level (feet) 16 below top of ground.
(4) casing 4 X 3 (material), 670 (depth)
4 X 3 (size) if telescope see back.
(5) screen 30 (length), 670 (depth to top)
3" (size), STAINLESS (material)
(6) pump See own Pump (HP), (yield gpm)
Elec. (type power)
(7) electric log Yes (yes or no)
Miss. Geo. Survey (organization running log)
(8) how well bottom plugged 1 1/2" x 2"

CODED

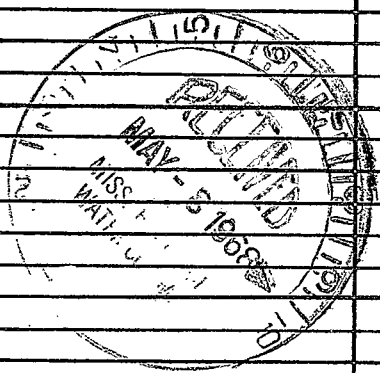

DRILLERS REMARKS:

