

SHARKEY MISSISSIPPI BOARD OF WATER COMMISSIONERS

A43

7-26-65

WATER WELL DRILLERS LOG

CODED

Date: 7/26, 1965, Driller: Pailey Oil Co County: Washington
 (Name)

(1) Owner of Land: W C Skates
 (Name)
Avon, Miss.
 (Address)

(2) Location: $\frac{1}{4}$, $\frac{1}{4}$, Sec. 14 T14R6
at Delta City
 (distance) miles (direction) of (Nearest Town)

(3) Topography: Flat
 (Hilly) (Flat) (Level)

(4) Purpose of Well: Domestic
 (Domestic Irrigation
 Municipal, Industrial, Other)

Description & Color of Materials Sand, Clay, Red Clay, Shell, etc.	Thick- ness Feet	Depth Feet
<u>Clay</u>		<u>20</u>
<u>Sand</u>		<u>80</u>
<u>Gravel</u>		<u>130</u>
<u>Mud</u>		<u>200</u>
<u>Sand</u>		<u>280</u>
<u>Mud</u>		<u>500</u>
<u>Mud & Sand</u>		<u>530</u>
<u>Sand</u>		<u>602</u>

Information upon completion of well:

(1) Diameter 4x2 inches.

(2) Total Depth 602 feet.

(3) Water Level 11 feet below top of ground.

(4) Cased to all way size 4x2.

(5) Screen: Size 2, Length 20ft.


(6) Were any formations sealed against pollution?
 _____ yes, X no.

CODED

If YES depth of formation _____

Why _____

Drillers Remarks: _____

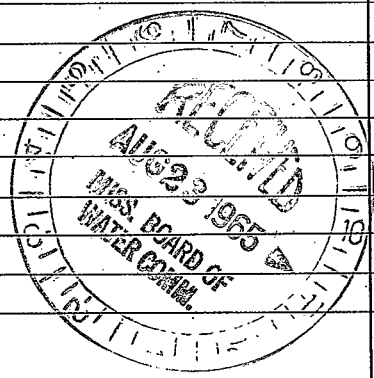

(Use Back Side)

Well No.

