

SHARKEY
A-44
9-15-71

MISSISSIPPI
 BOARD OF WATER COMMISSIONERS
 416 North State Street
 Jackson, Mississippi 39201

CODED

WATER WELL DRILLERS LOG

9/15 1971 Bailey Drilling Co Sharkey
 date well completed firm name county well located

LANDOWNER: Panther Burn Co

| description of formations encountered | from | to |
|---------------------------------------|------|-----|
| Clay | 0 | 30 |
| Sand | 30 | 80 |
| Gravel | 80 | 138 |
| Mud | 138 | 145 |
| Rock | 145 | 146 |
| Mud | 146 | 210 |
| Sand | 210 | 315 |
| Mud | 315 | 496 |
| Rock | 496 | 497 |
| Mud | 497 | 520 |
| Sand | 520 | 535 |
| Mud | 535 | 595 |
| Sand | 595 | 692 |

Panther Burn

Miss
 (mailing address)

WELL LOCATION:
 sec. 18 T. 14 N. R. 6 W.
13
1/2 miles S of Panther Burn
 (distance) (direction) (nearest town)

WELL PURPOSE: Home
 (home, irrigation, municipal, industrial)

WELL COMPLETION DATA:

- (1) diameter (inches) 6x4x3
- (2) total depth (feet) 692
- (3) static water level (feet) 21 below top of ground. ~~45~~ above
- (4) casing Steel, 662,
 (material) (depth)
- 6x4x3 if telescope see back.
 (size)
- (5) screen 30', 662
 (length) (depth to top)
- 3", stainless steel
 (size) (material)
- (6) pump 5, 60
 (HP) (yield gpm)
- Elec
 (type power)
- (7) electric log No
 (yes or no)

CODED

(organization running log)

(8) how well bottom plugged Check pressure valve

DRILLERS REMARKS:

SEP 20 1971

MISS. BD. OF
 WATER COMMISSIONERS

If well telescopes please sketch and show depths.


GROUND LEVEL

165' 6"

165' 11"

326' 3"

30' 3" str

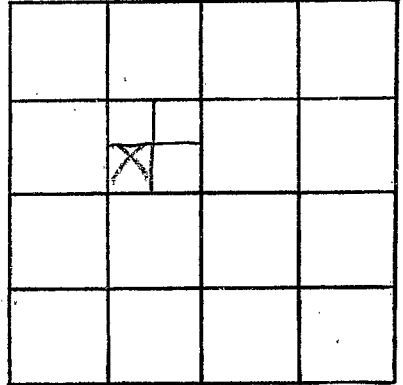

SECTION 18

Please indicate well location X.

ADDITIONAL INFORMATION

If more than one screen, show locations of each on sketch.