

SHARKEY
A 46
6-10-73

MISSISSIPPI
 BOARD OF WATER COMMISSIONERS
 416 North State Street
 Jackson, Mississippi 39201

CODED

WATER WELL DRILLERS LOG

6-10 1973 DYER WELL & IRRIGATION SERVICE **SHARKEY**
 date well completed firm name county well located

LANDOWNER: ~~W. C. Patterson~~

description of formations encountered

from

to

PANTHER BRAND PUT

Clay

0

33

PANTHER BRAND, MISS.,
 (mailing address)

Sand gravel

33

105

WELL LOCATION:

sec. 15 T. 14 N. R. 7 E. Yuma
 4 miles N.W. of NITTA
 (distance) (direction) (nearest town)

WELL PURPOSE:

(home, irrigation, municipal, industrial)

CODED

WELL COMPLETION DATA:

- (1) diameter (inches) 16"
- (2) total depth (feet) 103'
- (3) static water level (feet) 6' below above top of ground.
- (4) casing BLK IR, 6.3',
 (material) (depth)
16" if telescope see back.
 (size)
- (5) screen 40', 6.3'
 (length) (depth to top)
16", BLK IR
 (size) (material)
- (6) pump 50 2750
 (HP) (yield gpm)
DIESEL
 (type power)
- (7) electric log N/O
 (yes or no)
- (organization running log)
- (8) how well bottom plugged PLATE


DRILLERS REMARKS:

NOV 25 1973

MISS. DIV. OF
 WATER CONTROL

If well telescopes please sketch and show depths.

GROUND LEVEL

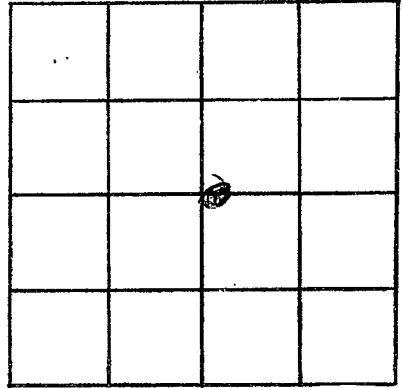

SECTION 15

Please indicate well location X.

ADDITIONAL INFORMATION

If more than one screen,
show locations of each on sketch.