

**SHARKEY**  
**A 48**  
**3-19-74**

MISSISSIPPI  
 BOARD OF WATER COMMISSIONERS  
 416 North State Street  
 Jackson, Mississippi 39201

**CODED**

**WATER WELL DRILLERS LOG**

March 19 19 74 Singer-Layne Central Div. Sharkey  
 date well completed firm name county well located

LANDOWNER:	description of formations encountered	from	to
Panther Burn Company			
Panther Burn, Mississippi (mailing address)	Clay	0	20
	Coarse Sand	20	40
	Gravel	40	108
	Pink Clay	108	--
<b>WELL LOCATION:</b>			
sec. 13 T 14 N R 7 E 4 miles West of Panther Burn, Ms. (distance) (direction) (nearest town)			
<b>WELL PURPOSE:</b> Irrigation (home, irrigation, municipal, industrial)			
<b>WELL COMPLETION DATA:</b>			
(1) diameter (inches) 16"			
(2) total depth (feet) 108'			
(3) static water level (feet) 12' below top of ground.			
(4) casing Steel, 58' (material) (depth) 16" (size) if telescope see back.			
(5) screen 50' 108' (length) (depth to top) 16" (size) Steel (material)			
(6) pump 60 2400 (HP) (yield gpm) Engine (type power)			
(7) electric log No (yes or no)			
(organization running log)			
(8) how well bottom plugged Plate			
<b>DRILLERS REMARKS:</b>			

**CODED**


RECORDED

APR 10 1974

MISS. Bd. of WATER COMMISSIONERS

If well telescopes please sketch and show depths.

GROUND LEVEL

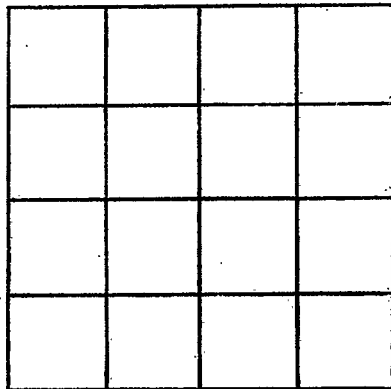

SECTION \_\_\_\_\_

Please indicate well location X.

ADDITIONAL INFORMATION

If more than one screen, show locations of each on sketch.