

SHARKEY
A 49
1-28-75

MISSISSIPPI
BOARD OF WATER COMMISSIONERS
416 North State Street
Jackson, Mississippi 39201
WATER WELL DRILLERS LOG

C17556

CODED

January 28, 1975 Singer-Layne Central Div. Sharkey
date well completed firm name county well located

LANDOWNER:	description of formations encountered	from	to
Panther Burn Company			
Panther Burn, MS (mailing address)	Clay	8	40
WELL LOCATION:	Coarse Sand	40	55
sec. 13 T 14 N R 7	Coarse Sand Gravel	55	70
2 miles north of Panther Burn	Gravel	70	90
(distance) (direction) (nearest town)	Coarse Sand Gravel	90	110
WELL PURPOSE: Irrigation	Clay	110	112
(home, irrigation, municipal; industrial)			
WELL COMPLETION DATA:			
(1) diameter (inches) 16"			
(2) total depth (feet) 110'			
(3) static water level (feet) 10' below top of ground.			
(4) casing steel 60' (material) (depth)			
16" (size) if telescope see back.			
(5) screen 50' 60' (length) (depth to top)			
16" (size) steel (material)			
(6) pump 60 2400 (HP) (yield gpm)			
engine (type power)			
(7) electric log no (yes or no)			
(organization running log)			
(8) how well bottom plugged with plate			
DRILLERS REMARKS:			


CODED

FEB 8 - 1975

MISS. BD. OF WATER COMMISSIONERS

If well telescopes please sketch and show depths.

GROUND LEVEL

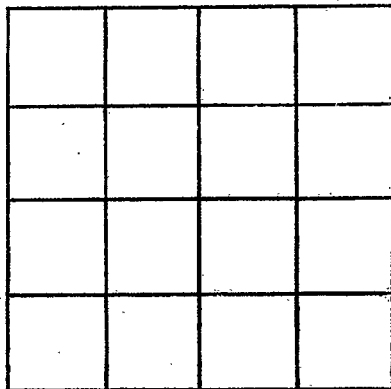

SECTION _____

Please indicate well location X.

ADDITIONAL INFORMATION

If more than one screen, show locations of each on sketch.