

MISSISSIPPI BOARD OF WATER COMMISSIONERS

WATER WELL DRILLERS LOG CODED

Date: 7/31, 1968, Driller: Bailey Drlg Co County: Washington *SHARKEY*


(1) Owner of Land:	Description & Color of Materials	Thick-ness Feet	Depth Feet
<u>Cameta Plantation</u> (Name)	Sand, Clay, Red Clay, Shell, etc.		
<u>Anguilla, Miss.</u> (Address)	<u>Clay</u>	<u>0</u>	<u>40</u>
(2) Location: <u>1/4</u> , <u>1/4</u> , Sec. <u>32</u> ^{14N, 6W} T R	<u>Sand</u>	<u>40</u>	<u>90</u>
<u>3</u> miles <u>N</u> of <u>Anguilla</u> (distance) (direction) (Nearest Town)	<u>Gravel</u>	<u>90</u>	<u>190</u>
(3) Topography: <u>Flat</u> (Hilly) (Flat) (Level)	<u>Mud</u>	<u>190</u>	<u>225</u>
(4) Purpose of Well: <u>Farm</u> (Domestic Irrigation Municipal, Industrial, Other)	<u>Mud + Sand</u>	<u>225</u>	<u>370</u>
	<u>Mud</u>	<u>370</u>	<u>500</u>
	<u>Sand</u>	<u>500</u>	<u>520</u>
	<u>Mud</u>	<u>520</u>	<u>570</u>
	<u>Sand</u>	<u>570</u>	<u>562</u>
	<u>Mud</u>	<u>562</u>	<u>668</u>
	<u>Rock</u>	<u>668</u>	<u>669</u>
	<u>Mud</u>	<u>669</u>	<u>740</u>
	<u>Rock</u>	<u>740</u>	<u>742</u>
	<u>Mud</u>	<u>742</u>	<u>750</u>
	<u>Sand</u>	<u>750</u>	<u>765</u>
	<u>Mud</u>	<u>765</u>	<u>772</u>
	<u>Sand</u>	<u>772</u>	<u>749</u>

Information upon completion of well:

- (1) Diameter 4 X 3 inches.
- (2) Total Depth 799 feet.
- (3) Water Level 17 feet below top of ground.
- (4) Cased to all way, Size 4 X 3.
- (5) Screen: Size 3", Length 30'.
- (6) Were any formations sealed against pollution?
X yes, X no.

CODED

799
30
769

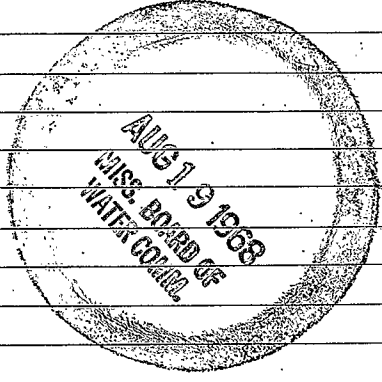

If YES depth of formation _____
Why _____
Drillers Remarks: _____

(Use Back Side)

Well No.

